

Pawnee KANSAS

SEC.	TWP.	R.
18	23	17 W

WELL NO. # 1 A. Strobel FARM
 COMPANY

Sunray Oil
 CONTRACTOR

Hilton Drlg.


Garfiled Pool

330 Ft. from N. Line

Ft. from S. Line

330 Ft. from E. Line

Ft. from W. Line

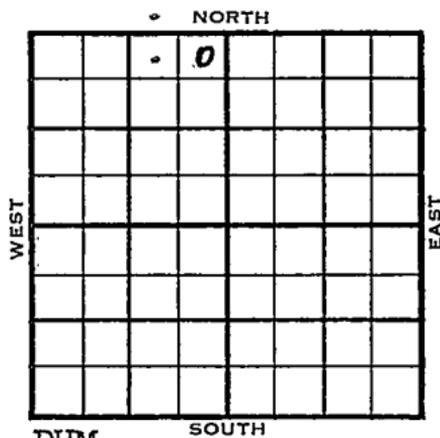

NE NE NW

Phillips, Hilton & NCRA - DHM

1955	ELEVATION	REPORT
	2080'	
1/19	Spud 1-14-55 8" @ 281 Anhy 1124 Drlg. 1958'	
3/9	Spud 1-14-55 - Oil Well TD 4420' 8" @ 281' Anhy 1124', Heeb 3666', Br lime 3773', Lans. 3781', B KC 4149', Cong 4212', Cong. sd 4230' DST 4241-46', opn 1 1/2 hrs., rec. 60' vsocm, 60' gassy ocm, 290# Ch. Cong. 4248' DST 4248-70', opn 1 hr., gas in 40", rec. 30' socm, 210' gassy oil, 390' msw, 1300# DST 4276-4318', opn 1 hr., rec. 60' socm, 1270# DST 4335-60', opn 1 hr., rec. 30' socm, 110' swcm, 1020# TD 4420' 5" @ 4419' Schl Tops: Heeb. 3666', Br lime 3771', Lans. 3780', B KC 4150', Cherokee 4212', Ch. Cong. 4230', Misner 4342', XXXXXX Viola 4392'	

(Information Brought Forward)

1955
3/9

CO, 48/4346-54
10 gwph
24/4340-44, 14 gwph frac
SP 4342 56/4280-94, 2/3 bo 1/3 bw
6 hrs., SP 4272, 32/4251-59, 1 goph
8 hrs., 250A frac 21 bf 8 to 10% wtr
S/117 bf 5% wtr 6 hrs.
P/96 bopd
Comp. 111 bopd

COMPLETED


County Pawnee State Kansas

Sec. 18 (Blk. Twp.) 23 (Sur. Rge.) 17W Map No.

Operator Sunray Oil

Well No. 1 Farm A. Strobel

Elev. 2080 Location NE NE NW

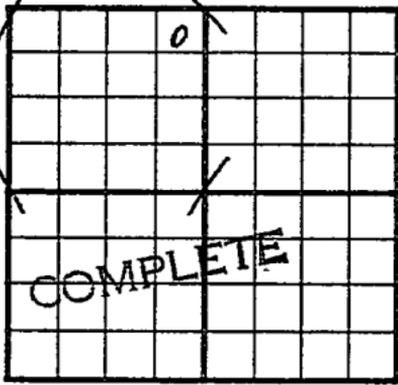

330 Ft. From N Line NW c

330 Ft. From E Line Quarter

1st. Report

Completion MAR 9 1955

Remarks Garfield Pool
Hilton Drlg. - Contr.

Spudding Date 1-14-55

Drlg. Data Oil well TD 4420

8" @ 281 Anhy 1124 Heeb. 3666

Br. lime 3773 Lans. 3781 B KC 4149

Cong. 4212 Cong. sd. 4230 DST 4241-46

open 1 1/2 hr. Rec. 60' vsocm 60' gassy

ocm 290# Ch. Cong. 4248 DST 4248-70

open 1 hr. gas in 40 min. Rec. 30' socm

210' gassy oil 390' msw 1300#

DST 4276-4318 open 1 hr. Rec. 60' socm

1270# DST 4335-60 open 1 hr. Rec. 30'

socm 110' swcm 1020# TD 4420

5" @ 4419 SCHLUMBERGER TOPS:

Heeb. 3666 Br. lime 3771 Lans. 3780

B KC 4150 Cherokee 4212 Ch. Cong. 4230

Misener 4342 Viola 4392 CO 48/ 4346-54

FABEN GILSTRAP

Drlg. Data

10 gwph 24/ 4340-44 14 gwph frac

SP 4342 56/ ~~4280-94~~ 2/3 bo 1/3 bw

6 hr. SP 4272 32/ 4251-59 misc. gwph

8 hr. 250 A frac 21 6r 8 to 10% wtr

S/ 117 bf 5% wtr. 6 hr. P/ 96 bopd

Comp. 111 bopd

Land Wall Map
 Land Small Map
 About 1/2 in

MAR 15 1966