


Section 18 Township 23 Range 17W

Well No. 2 A. Strobel

Company Sunray Oil

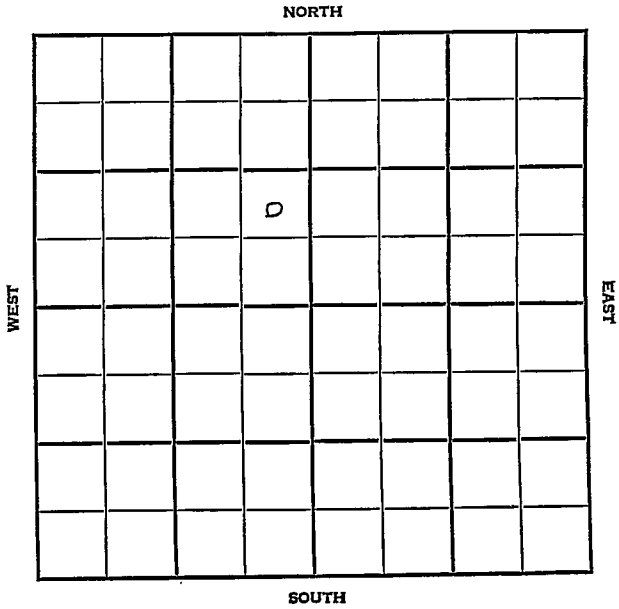

18 23 - - 17 W

WELL NO. # 2 A. Strobel FARM
 COMPANY

CONTRACTOR Sunray Oil

Stickle


Garfield Pool
 _____ Ft. from N. Line

990 _____ Ft. from S. Line

330 _____ Ft. from E. Line

_____ Ft. from W. Line

NE SE NW

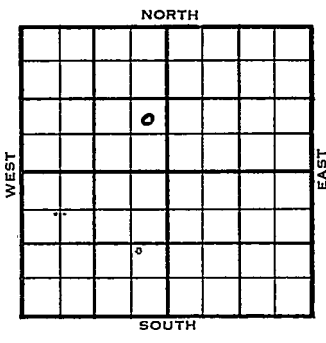

1955	ELEVATION	REPORT
	2085'	

4/27 Location
 5/19 TD 4427'. Prep to run 5 1/2" csg. (DR-99)
 5/20 TD 4427'. WOC 5 1/2" csg @ 4425' (DR-100)
 5/23 TD 4427'. Perf 4260-64.
 Swabbed 1 hr @ 480 BO/d rate.
 No water. (DR-101)
 5/24 TD 4427'. Tested 226 BO & 14
 BW day rate. (DR-102)
 5/25 TD 4427'. Setting pump unit. (DR-103)
 5/31 " " (DR 106)
 5/26 TD 4427' 5 1/2" @ 4425' w/200 sax, CO to
 & 4384, 24/4260-64, FU 127' oil in
 20 min, S/2 1/2 bo, no wtr in 30 min,
 150' off bottom, S/16 bo, no wtr. 1st
 hr., S/20 bo no wtr 2nd hr S/9 1/4 bo
 plus 6 bw for 10 hr., T&R
 6/2 POP
 6/9 Shut down for tank room.
 6/16 P/80 BO 16 hr.
 P/102 BO 20 hr.

OVER

6/22

Comm 5-5-55

H 3672
Tr 3690
BL 3776
KC 3785

BKC 4185

CE Cherokee 4221 Ce Cherokee 4221

C 4238

C 4239

Cong sd 4340

Cong sd 4350

V 4401

V 4393

TD 4427

8 5/8" @ 315/350 DST 4238-54

open 1 hr Rec 10' mud 15#

DST 4255-65 open 1/2 hr gas in 6

min. Rec 1170' clean oil 120' sw

1345/30" DST 4282-96 open 1/2 hr

Rec 65' socm 165/30" 5 1/2" @ 4425

/200 CO to 4384 24/4260-64

FU 127' oil 20 min B/2 1/2 bo 1/2 hr

S/16 bo 1 hr

S/20 bo 2nd hr S/94 bo 6 bw 10 hr

P/80 bo 16 hr px P/102 bo 20 hr

P/31.77 bo 8 hr

Comp & 95 bopd

COMPLETED

County Pawnee Elev. 2085
 Sec. 18 Twp. 23 Rge. 17W
 Company Sunray Oil Corp.
 Farm Name A. Strobel No. 2

TOPS	DEPTH	LOG	DATUM
Anh.			
TP.			
H.		.3672	1587
Tr.		.3690	11005
Dg.			
BL.		.3776	1691
L.			
K.C.		3785	1700
B.K.C.	4185		2070
Ce. Cherokee	4221	4221	2113
C.	4238	4239	2150
M. Cong sd	4340	4350	2265
M.			
K.			
Mz.			
Mq.			
V.	4401	4393	2308
S.			
S.			
A.			
R.	22660+146W		
PE.	PE		2175-79
G.	5 1/2		2340
TD.	4427		2342

Loc. in Sec. _____
 NE SE NW
 Geol. _____
 Contr. _____
 Stickle
 Pool ~~Garfield~~
 COMPLETE

Date Comm. 5-5-55 JUN 22 1955
8 5/8" @ 315/350. DST 4238-54.
open 1 hr. Rec. 10' mud 15#
DST 4255-65 open 1/2 hr. gas in 6 min.
Rec. 1170' clean oil 120' sw 1345/30"
DST 4282-96 open 1/2 hr. Rec. 65' socm
165/30" 5 1/2" @ 4425/200 CO to 4384
24/ 4260-64 FU 127' oil 20 min.
B/ 2 1/2 bo 1/2 hr. S/ 16 bo 1 hr.

Co.
Lse.
No.
Sec.
T.
R.

S/ 20 bo 2nd hr. S/ 94 bo 6 bw 10 hr.

P/ 80 bo 16 hr. P/ 102 bo 20 hr.

P/ 31.77 bo 8 hr. -Comp. 95 bopd

_____	Misc.
_____	Pierce Map
_____	France Map
_____	Tracings
_____	Land Wall Map
_____	Land Small Map
_____	Scout Cards

mm

JUN 29 1955