


Section 18 Township 23 Range 33 W

Well No. # 5 Garden City

Company Northern Pump

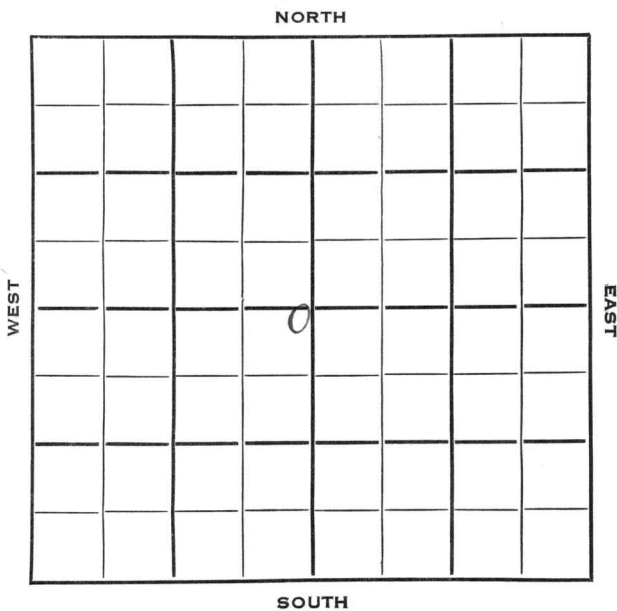

Finney KANSAS


SEC.	TWP.	R.
18	23	33W ✓

WELL NO. _____
 5 Garden City FARM

COMPANY _____
 Northern Pump

CONTRACTOR _____
 Northern Pump

150 _____ Ft. from N. Line
 _____ Ft. from S. Line
 150 _____ Ft. from E. Line
 _____ Ft. from W. Line

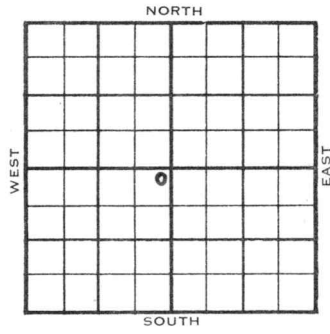

NE NE SW

Stanolind F/O

	ELEVATION	REPORT
1954	2907'	
3/31	MIR	
4/7	Her. 2548', Kr. 2567', Win 2598' RTD 2600' 7" @ 2599'	
4/28	Spud 3-31-54 Gas Well TD 2600' Her. 2548', Kri 2567' Win 2598' TD 2600' 7" @ 2599' CO to 2597 60/ 2548-63 frac 52/ 2571-84 CO to 2604 5 1/2 mcfg. Comp 9,530,000 gas 411#	

COMPLETED

County Finney State Kansas

Sec. 18 (Blk.) 23 (Sur.) 33W Map No.

Operator Northern Pump

Well No. 5 Farm Garden City

Elev. Location NE NE SW

FIRST REPORT					
		0			

150Ft. From N Line SW

150Ft. From E Line Quarter

Ist. Report MAR 31 1954

Completion

Remarks Stanolind farmout

Northern Pump - Contr.

Spudding Date

Drig. Data

M I R

County Finney State Kansas

Sec. 18 (Blk. 23) (Sur. Rge.) 33W Map No.

Operator Northern Pump

Well No. 5 Farm Garden City

Elev. 2907 Location NE NE SW

COMPLETE									

150 Ft. From N Line SW

150 Ft. From E Line Quarter

1st. Report

Completion APR 28 1954

Remarks

Northern Pump - Contr.

Spudding Date 3-31-54

Drlg. Data Gas well TD 2600

Her. 2548 Kri. 2567 Win. 2598

TD 2600 7" @ 2599 CO to 2597

60/ 2548-63 frac 52/ 2571-84

CO to 2604 5½ mcf/g

Comp. 9,530,000 gas 411#