


Section 18 Township 23 Range 34-W

Well No. #1 Gorden City

Company Champlin Ref.

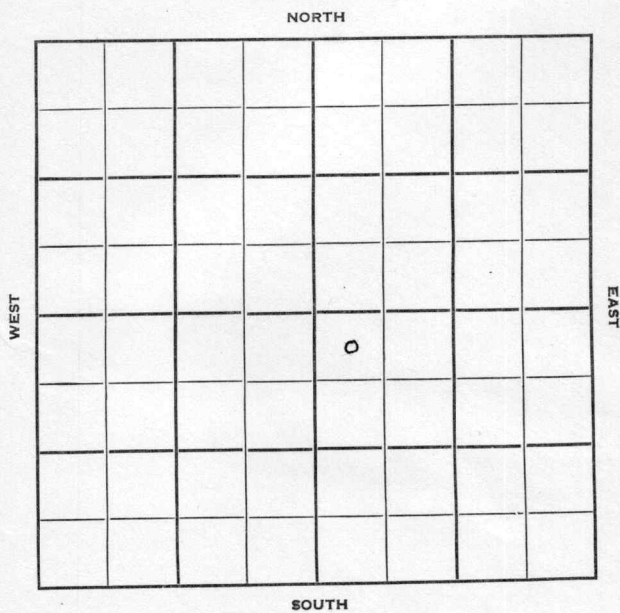

18

23

34W

Sec. _____ Twp. _____ R. _____

Well No. #1 Gorden City Farm

Champlin Refg. Company

Contractor


330' Ft. from N. Line

Ft. from S. Line

Ft. from E. Line

330' Ft. from W. Line

NW NW SE

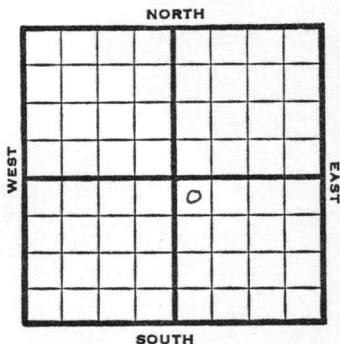

1950

Elev 2981

REPORT

5/24

Location

8/2

10" @ 604

Her 2453

Krider 2489

Win 2539

Towanda 2600

7" @ 2653

TD 2655

54/2623-32, 48/2608-16, 36/2600-06

60/2556-66, 84/2539-53, 96/2502-18

60/2489-99

20,000 total acid

Comp. Del 2,767,000 gas 416#

Completed

COMPLETED

Kansas

Map No. _____ Sec. 18 Twp. 23 R. 34W

Well No. 1 Gorden City

Champlin Ref. Company

Contractor

NW NW SE

SECTION PLAT

330 Ft. from N. Line

_____ Ft. from S. Line

_____ Ft. from E. Line

330 Ft. from W. Line

		○	
FIRST		REPORT	

Finney

Location X

Rig up _____

Drilling and Remarks:

RECORD

Cased _____ in., _____ ft.

Sand _____

Gas _____

Oil _____

Total Depth _____

PRODUCTION

1st 24 hrs. Nat. _____

1st 24 hrs. after shot _____

Gas _____ Cu. Ft.

Dry Hole _____

Abandoned _____

Date

MAY 24 1950

19

J. E. TYRA

Scout

