
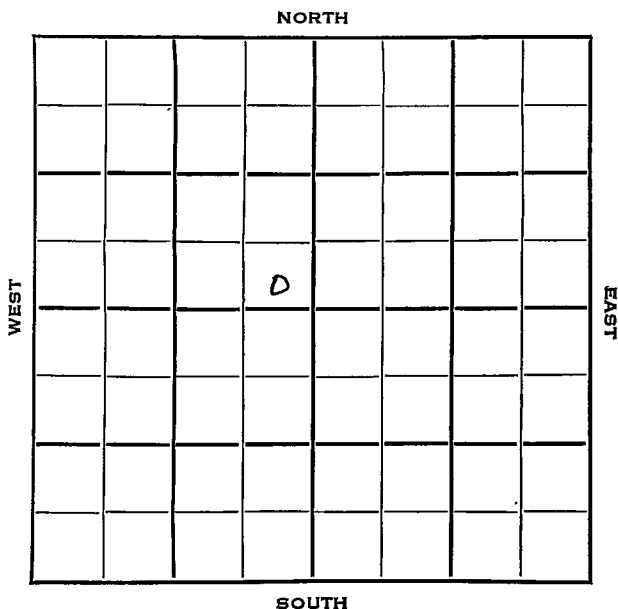


Section 18 Township 23 Range 35WWell No. 1 MadduxCompany Stanolind

Sec. 18 Twp. 23 R. 35W

Well No. #1 Maddux Farm
Stanolind Company
Contractor

Ft. from N. Line
150 Ft. from S. Line
150 Ft. from E. Line
Ft. from W. Line
SE NW

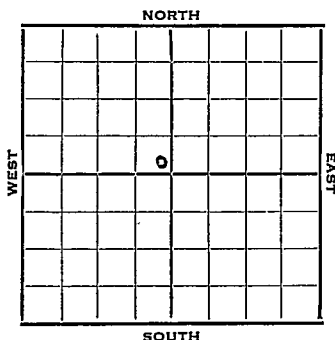

1952 Elev. 3065' REPORT

12/10 Spud 12-1-52
8" @ 728
Drlg. 2480'

12/11 Ø2480

12/18 Her 2527 Winfield 2583 RTD 2608 5"
Fe @ 2583

12/25 " " " "

1953

1/7 Spud 12-1-52

Gas Well

TD 2608

8" @ 728

Her. 2527, Win. 2583

TD 2608

5" @ 2583

CO to 2608

5000A SP 2578


96/2538-54, 12/2561-63

48/2567-75 5000A 2000A

Comp. 9½ mcf/gpd

COMPLETED

J. G. McGEHEE

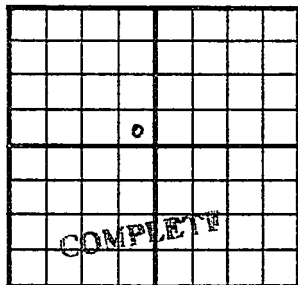County Kearny State KansasSec. 18 (Blk.
Twp.) 23 (Sur.
Rgs.) 35W Map No.Operator StanolindWell No. 1 Farm MadduxElev. 3065 Location SE NW150 Ft. From S Line NW150 Ft. From E Line Quarter

1st. Report

Completion JAN 7 1953

Remarks

Spudding Date 12-1-52Drig. Data Gas well TD 26088" @ 728 Her. 2527 Win. 2583TD 2608 5" @ 2583 CO to 26085000 A SP 2578 96/ 2538-54 12/ 2561-6348/ 2567-75 5000 A 2000 AComp. $9\frac{1}{2}$ mcf/gpd