


Section 19 Township 23 Range 3-W

Well No. 2 Cunningham

Company Bennett & Wilhelm

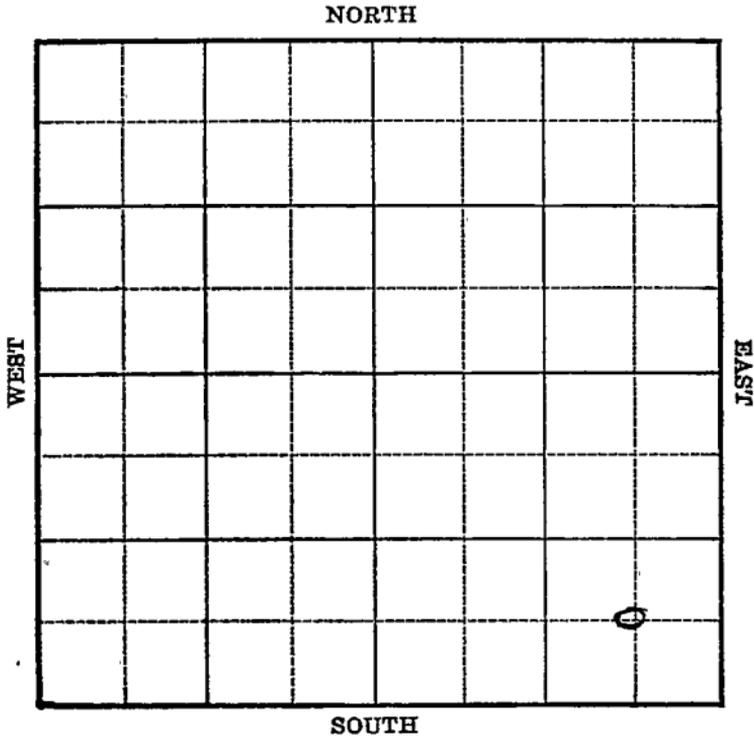

Sec. 19 Twp. 23 R. 3-W

Well No. #2 Cunningham Farm

Bennett & Wilhelm Company


_____ Ft. from N. Line

660 Ft. from S. Line

660 Ft. from E. Line

_____ Ft. from W. Line

Elev. 1458

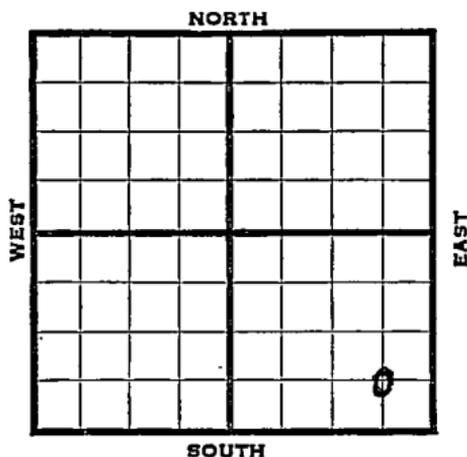

1938	REPORT
11/16	R U R
11/25	10" - 262'. Drlg. 1535'.
12/2	Drlg. 2885'.
12/9	Chat. 3260'. 5" - 3270' T.D. RUST.
12/15	T. D. 3365'. 2000 acid. Pumping 40 oil per hour.
12/21	5" - 3272'..
	Chat. 3260'.
	T. D. 3365'.
	2000 acid.
	Pump 336 bbls. 8 hrs.
	Potential 1007 bbls.
	COMPLETED

Harvey **KANSAS**Map No. 29 Sec. 19 Twp. 23 R. 3WWell No. 2 CunninghamBennett & Wilhelm Company

Contractor

FIRST REPORT

C SE SE

SECTION PLAT

			0

 Ft. from N. Line660 Ft. from S. Line660 Ft. from E. Line Ft. from W. LineLocation Rig up

Drilling and Remarks:

RUR

RECORDCased in., ft.Sand Gas Oil Total Depth **PRODUCTION**1st 24 hrs. Nat. 1st 24 hrs. after shot Gas Cu. Ft.Dry Hole Abandoned

Date

NOV 16 1938

19H. D. Hatfield Scout

Harvey **KANSAS**Map No. 39 Sec. 19 Twp. 23 R. 3WWell No. 2 CunninghamBennett & Wilhelm

Company

Contractor

COMPLETED**SECTION PLAT****C SE SE**

_____ Ft. from N. Line

660 Ft. from S. Line660 Ft. from E. Line

_____ Ft. from W. Line

BURTON POOL

			0

Location _____

Rig up _____

Drilling and Remarks:

*2000 acid**P-336/8**POT 1007***RECORD**Cased 5 in., 3272 ft.Sand CHAT 3260

Gas _____

Oil _____

Total Depth 3365**PRODUCTION**

1st 24 hrs. Nat. _____

1st 24 hrs. after shot _____

Gas _____ Cu. Ft.

Dry Hole _____

Abandoned _____

Date

DEC. 21 1938

19

H. D. Hatfield

Scout