


Harvey

Form 51-5M-2-29-34703

Map No. KANSAS Sec. 19 Twp. 23 R. 3w

Well No. 1- Day Farm  
Olsen & Shell Company

NORTH

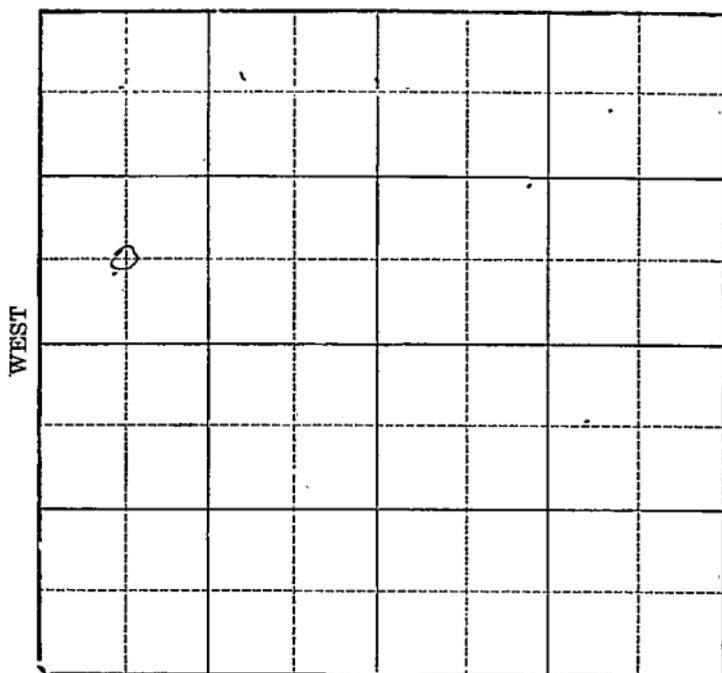

SOUTH

Location \_\_\_\_\_

Drilling Remarks \_\_\_\_\_

\_\_\_\_\_

\_\_\_\_\_

RECORD

Cased \_\_\_\_\_ in. \_\_\_\_\_ ft.

Sand \_\_\_\_\_

Gas \_\_\_\_\_

Oil \_\_\_\_\_

Total Depth \_\_\_\_\_

Rig Up \_\_\_\_\_

Drilling Remarks \_\_\_\_\_

\_\_\_\_\_

\_\_\_\_\_

PRODUCTION

1st 24 hrs. Nat. \_\_\_\_\_

1st 24 hrs. after shot \_\_\_\_\_

Gas \_\_\_\_\_ cu. ft. \_\_\_\_\_

Dry Hole \_\_\_\_\_

Abandoned \_\_\_\_\_

Map No. KANSAS Sec. 19 Twp. 23 R. 3<sup>w</sup>

Well No. 1- Day Farm  
Olsen & Shell Company


\_\_\_\_\_ Ft. from N. Line

660 Ft. from S. Line

\_\_\_\_\_ Ft. from E. Line

660 Ft. from W. Line

1932

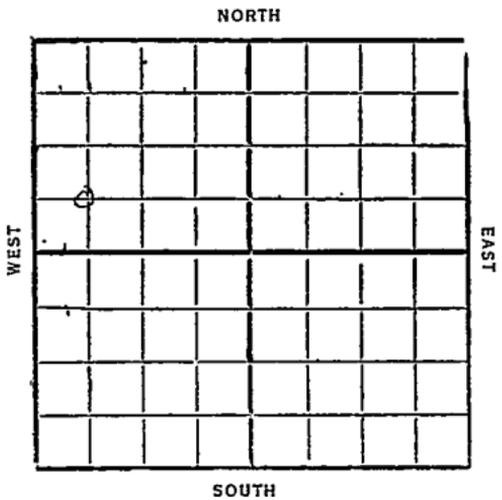

Date REPORT

6/22	Loc
6/29	Blush pond
7/6	set 270' ht sur pipe
7/13	dreg 1810'
7/20	" 2640'
7/27	SD 3123 Re-cem 15"
8/3	Top Chat 3263 8"-3284 dreg 3293
8/10	TD 3371 1/2 At gas and make one blow each pair
8/17	TD 3371 Rng 2" tubing
8/24	TD 3371 No test
8/31	—
9/7	Cased 8"-3284 Chat 3263-3371 TD 3371 Flow 110 bbl 24 hr 37° grav 1/2 At gas

Comp

*Harvey*

**39**

**KANSAS**

Map No. .... Sec. *19* Twp. *23* R. *3*

Well No. *1* *Day*

*Olsen & Shee* Company

Contractor

**FIRST REPORTS**

..... Ft. from N. Line

*660* Ft. from S. Line

..... Ft. from E. Line

*660* Ft. from W. Line

**SECTION PLAT**

<i>0</i>			

Location

Rig up .....

Drilling and Remarks:

**RECORD**

Cased.....in., .....ft.

Sand .....

Gas .....

Oil .....

Total Depth .....

**PRODUCTION**

1st 24 hrs. Nat. ....

1st 24 hrs. after shot .....

Gas..... Cu. Ft.

Dry Hole .....

Abandoned .....

Date

**JUN 22 1932**

**CHAS. L. SHERWOOD**

192

Scout

*Harvey*

**39 KANSAS**

Map No. \_\_\_\_\_ Sec. *19* Twp. *23* R. *3* <sup>W</sup>

Well No. *1* \_\_\_\_\_

*Olsen & Shell* \_\_\_\_\_ Company

\_\_\_\_\_ Contractor

**COMPLETED**

**SECTION PLAT**

\_\_\_\_\_ Ft. from N. Line

*660* Ft. from S. Line

\_\_\_\_\_ Ft. from E. Line

*660* Ft. from W. Line

<i>0</i>			

Location \_\_\_\_\_

Rig up \_\_\_\_\_

Drilling and Remarks:

*Flow 110 Bcs  
24 Hrs.*

*37 Gravity*

**RECORD**

Cased *28* in., *3284* ft.

Sand *hat 3263-3371*

Gas \_\_\_\_\_

Oil \_\_\_\_\_

Total Depth *3371*

**PRODUCTION**

1st 24 hrs. Nat. \_\_\_\_\_

1st 24 hrs./after shot \_\_\_\_\_

Gas *1/2* Cu. Ft.

Dry Hole \_\_\_\_\_

Abandoned \_\_\_\_\_

Date

SEP 7 1932

**CHAS. L. SHERWOOD**

192

Scout