

KANSAS

Form 51-5M-7-40-Palace

Harvey

Section 19 Township 23 Range 3-W

Well No. 2 Day

Company Claude Wentworth

NORTH

Burrton Pool

		0				

WEST

EAST

SOUTH

23

Sec. 19 Twp. 23 R. 3-W

Well No. #2 Day Farm

Claude Wentworth

Company

(Burton)


330 Ft. from N. Line

_____ Ft. from S. Line

660 Ft. from E. Line

_____ Ft. from W. Line

Elev. 1464

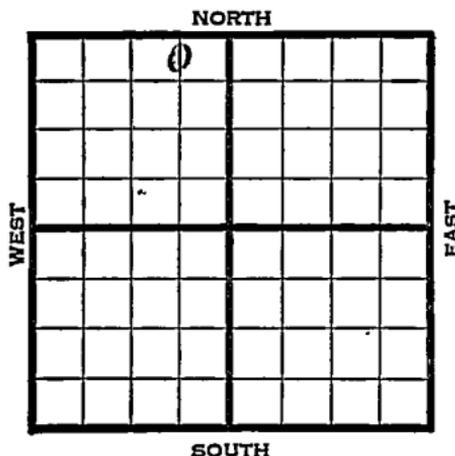

1941	REPORT
1/8	Derrick.
1/16	10" - 265' Drlg. 1200'
1/23	Drlg. 3060'
1/30	Miss. 3275' 5" - 3300'
4	T.D. 3311' WOC.
2/6	Drlg. 3330' S/Gas.
2/13	T.D. 3367' 1000' oil. 1000 acid.
2/20	Pump 48 bbls. oil.
2/27	" " "
3/5	Miss. 3275' 5" - 3300' T.D. 3367' 1000 acid. Potential 264 oil & 150 water on pump. 36.6 Gravity
	COMPLETED

Map No. 39 Sec. 19 Twp. 23 R. 3W

Well No. 2 Day

Claude Wentworth Company

Contractor

FIRST REPORT

SECTION PLAT

C N E NE NW

330 Ft. from N. Line

_____ Ft. from S. Line

660 Ft. from E. Line

_____ Ft. from W. Line

	o		

BURRTON POOL

Location _____

Rig up _____

Drilling and Remarks:

Derrick

RECORD

Cased _____ in., _____ ft.

Sand _____

Gas _____

Oil _____

Total Depth _____

PRODUCTION

1st 24 hrs. Nat. _____

1st 24 hrs. after shot _____

Gas _____ Cu. Ft.

Dry Hole _____

Abandoned _____

Date

JAN 8 1941
19

S. J. LEWIS Scout

Map No. 39 Sec. 19 Twp. 23 R. 3W

Well No. 2 Day

Claude Wentworth Company

Contractor

COMPLETED

SECTION PLAT

C N L NE NW
330 Ft. from N. Line
 _____ Ft. from S. Line
660 Ft. from E. Line
 _____ Ft. from W. Line

	o		
		.	

BURRTON POOL

Location _____

Rig up _____

Drilling and Remarks:

*Misc 3275.
 5" @ 3300
 1000 acid
 Pump 264 x 150 W 2 1/2"
 Pat
 366 G.*

RECORD

Cased _____ in., _____ ft.

Sand _____

Gas _____

Oil _____

Total Depth 3367

PRODUCTION

1st 24 hrs. Nat. _____

1st 24 hrs. after shot _____

Gas _____ Cu. Ft.

Dry Hole _____

Abandoned _____

Date

MAR 5 1941 19

S. J. LEWIS Scout