


Harvey

Section 19 Township 23 Range 3-W

Well No. 1 Cunningham


Company Wilhelm & Nye

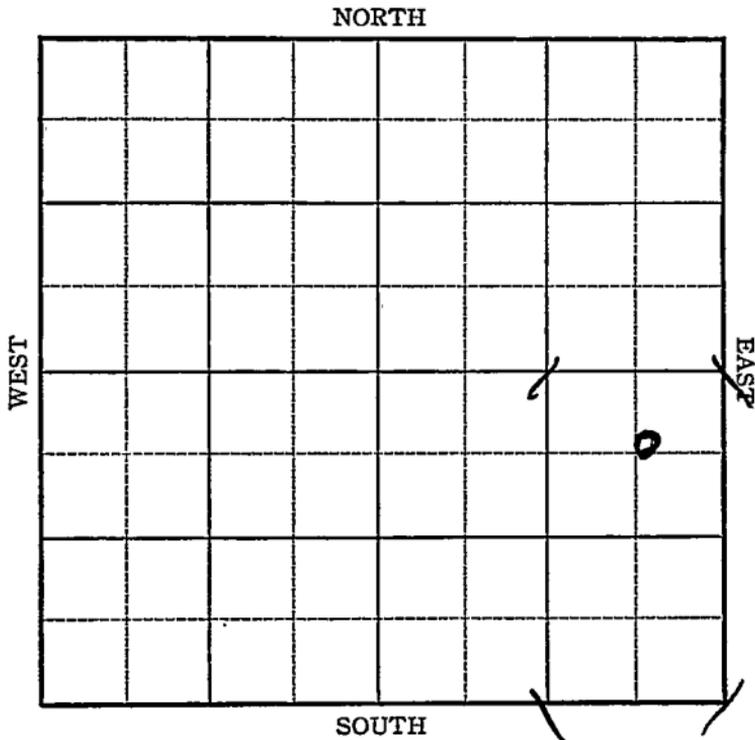

Sec. 19 Twp. 23 R. 3-W

Well No. #1 Cunningham Farm
 Wilhelm & Nye Company

Approx. C NE SE
 650 Ft. from N. Line
 _____ Ft. from S. Line
 552 Ft. from E. Line
 _____ Ft. from W. Line
 Elev. 1459

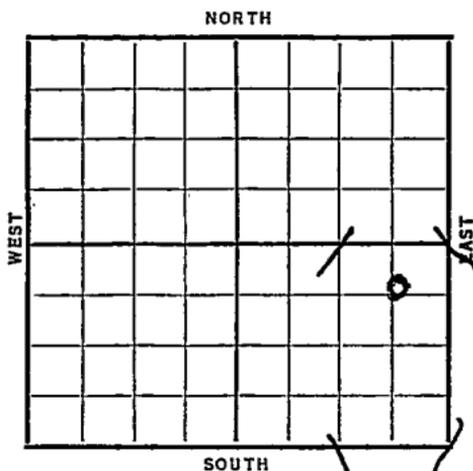

Date	REPORT
1937	
11/10	Cellar.
11/19	"
11/26	"
12/3	"
12/10	"
12/17	"
12/24	"
12/31	"
1938	
1/7	C.R.
1/14	R U R
1/20	" "
1/28	Drlg. 275'
2/4	12" - 262' T.D. 1167' S.D.
2/11	Drlg. 2399'.
2/18	Drlg. 3110'.
2/26	7" @ 3270'. RUST.
3/4	Chat 3256'? T.D. 3369'.
	Pay 3360-69'. 2000 acid.
	OVER

1938

3/9 7" @ 3270'.

Chat 3256'?

T.D. 3369'.

2000 acid.

Potential 847 oil.

Estimate 15 water.

Pump & flow.

COMPLETED

Map No. 39 Sec. 19 Twp. 23 R. 3W

Well No. 1 Cunningham

Wilhelm & Nye Company

FIRST REPORT Contractor

approx.


650 **C NE SE**
Ft. from N. Line

_____ Ft. from S. Line

552 Ft. from E. Line

_____ Ft. from W. Line

SECTION PLAT

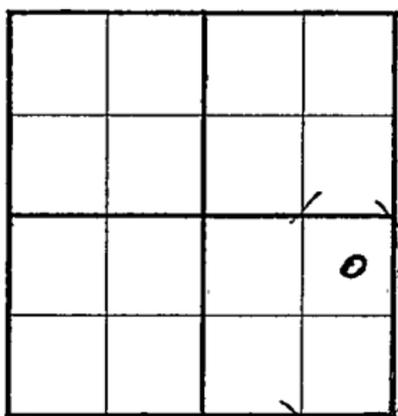

Location _____

Rig up _____

Drilling and Remarks:

Cellar

RECORD

Cased _____ in., _____ ft.

Sand _____

Gas _____

Oil _____

Total Depth _____

PRODUCTION

1st 24 hrs. Nat. _____

1st 24 hrs. after shot _____

Gas _____ Cu. Ft.

Dry Hole _____

Abandoned _____

Date

NOV 10 1937₁₉

H. D. Hatfield Scout

Map No. 39 Sec. 19 Twp. 23 R. 3WWell No. 1 CunninghamWilhelm & Nye Company**COMPLETED** Contractor

Approx.

C NE SE

650 Ft. from N. Line Ft. from S. Line552 Ft. from E. Line Ft. from W. Line

SECTION PLAT

			0

Location _____

Rig up _____

Drilling and Remarks:

*2000 acid**POT 847 oil
EST 15 WTR**Pump & Flow*

RECORD

Cased 7 in., 3270 ft.Sand Chat 3256?

Gas _____

Oil _____

Total Depth 3369

PRODUCTION

1st 24 hrs. Nat. _____

1st 24 hrs. after shot _____

Gas _____ Cu. Ft.

Dry Hole _____

Abandoned _____

Date

MAR 9 - 1938 19

H. D. Hatfield Scout