

KANSAS

Form 51-5M-7-40-Palace

Harvey


Section 19 Township 23 Range 3-W

Well No. 2 Dick

Mercury Drilling

Company ~~Claude Drlg.~~

NORTH Burrton Pool

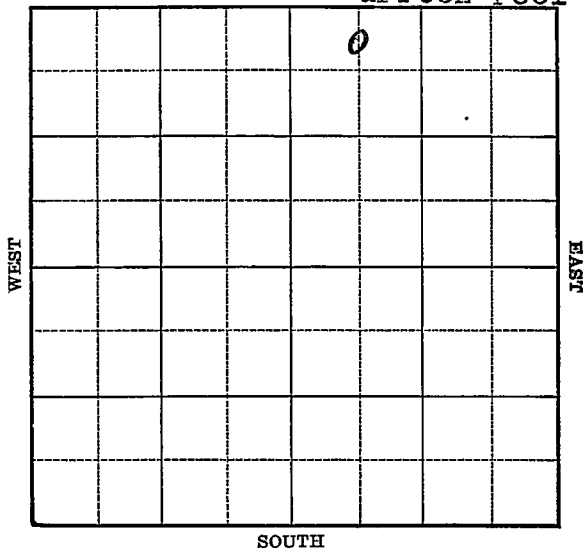

1941
3/26

Miss. 3266'
5" - 3325'
T.D. 3360'
2000 acid.
Potential 359 bbls., pump.
36.6 Gravity

COMPLETED

Map No. 39 Sec. 19 Twp. 23 R. 3WWell No. 2 DickClaude Drlg. Company

Contractor

FIRST REPORT

C N L NW NE

330 Ft. from N. Line Ft. from S. Line Ft. from E. Line660 Ft. from W. Line**BURRTON POOL****SECTION PLAT**

		o	

Location Rig up

Drilling and Remarks:

10" - 301Drlg. 2980**RECORD**Cased in., ft.Sand Gas Oil Total Depth **PRODUCTION**1st 24 hrs. Nat. 1st 24 hrs. after shot Gas Cu. Ft.Dry Hole Abandoned

Date

JAN 8 1911 19 S. J. LEWIS Scout

Map No. 39 Sec. 19 Twp. 23 R. 3WWell No. 2 DickMercury Drilling CompanyCORRECTION Contractor

SECTION PLAT

C N L NW NE
330 Ft. from N. Line Ft. from S. Line Ft. from E. Line660 Ft. from W. Line

BURRTON POOL

		o	

Location Rig up

Drilling and Remarks:

Reported

Claude Drlg.

RECORD

Cased in., ft.Sand Gas Oil Total Depth

PRODUCTION

1st 24 hrs. Nat. 1st 24 hrs. after shot Gas Cu. Ft.Dry Hole Abandoned

Date

FEB 19 1941

19.

S. J. EVI

Scout

Map No. 39 Sec. 19 Twp. 23 R. 3WWell No. 2 DickMercury Drilling Company~~COMPLETED~~ Contractor

C N L NW NE

330 Ft. from N. Line Ft. from S. Line Ft. from E. Line660 Ft. from W. Line

BURRTON POOL

SECTION PLAT

		o	

Location Rig up

Drilling and Remarks:

*Mus 3266**5" C3325.**2000 acid**Pump. 359 28**36 1/2 in.*

RECORD

Cased in., ft.Sand Gas Oil Total Depth 3360

PRODUCTION

1st 24 hrs. Nat. 1st 24 hrs. after shot Gas Cu. Ft.Dry Hole Abandoned

Date

MAR 26 1941 19 S. J. LEWIS Scout