


Harvey

KANSAS

Section 19 Township 23 Range 3-W

Well No. 2 Gouldner

Company Wilhelm & Bennett

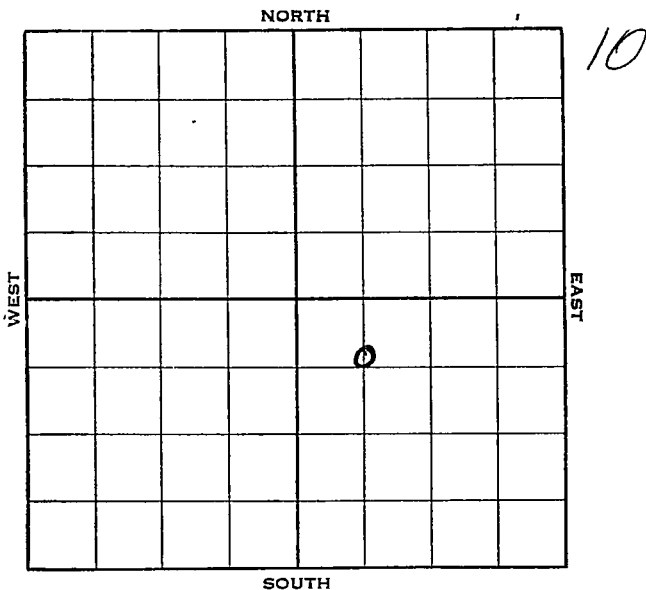



Harvey **KANSAS**

Map No. 29 Sec. 19 Twp. 23 R. 3W

Well No. 2 Gouldner

Wilhelm & Bennett Company

Contractor

**FIRST REPORT**

C NW SE

600 Ft. from N. Line

\_\_\_\_\_ Ft. from S. Line

\_\_\_\_\_ Ft. from E. Line

660 Ft. from W. Line

**SECTION PLAT**

		0	

Location \_\_\_\_\_

Rig up \_\_\_\_\_

Drilling and Remarks:

**RUR**

**RECORD**

Cased \_\_\_\_\_ in., \_\_\_\_\_ ft.

Sand \_\_\_\_\_

Gas \_\_\_\_\_

Oil \_\_\_\_\_

Total Depth \_\_\_\_\_

**PRODUCTION**

1st 24 hrs. Nat. \_\_\_\_\_

1st 24 hrs. after shot \_\_\_\_\_

Gas \_\_\_\_\_ Cu. Ft.

Dry Hole \_\_\_\_\_

Abandoned \_\_\_\_\_

Date

**MAR 23 1938** 19 \_\_\_\_\_ **H. D. Hatfield** Scout

Harvey **KANSAS**

Map No. 39 Sec. 19 Twp. 23 R. 3W

Well No. 2 Gouldner

Wilhelm & Bennett

Company

Contractor

**COMPLETED**

**SECTION PLAT**

**C NW SE**  
600 Ft. from N. Line  
 \_\_\_\_\_ Ft. from S. Line  
 \_\_\_\_\_ Ft. from E. Line  
660 Ft. from W. Line

		o	

Location \_\_\_\_\_

Rig up \_\_\_\_\_

Drilling and Remarks:

*2000 acid*  
*POT 892*  
*Flow*

**RECORD**

Cased 7 in., 3267 ft.  
 Sand CHAT 3254  
 Gas \_\_\_\_\_  
 Oil \_\_\_\_\_  
 Total Depth 3370

**PRODUCTION**

1st 24 hrs. Nat. \_\_\_\_\_  
 1st 24 hrs. after shot \_\_\_\_\_  
 Gas \_\_\_\_\_ Cu. Ft.  
 Dry Hole \_\_\_\_\_  
 Abandoned \_\_\_\_\_

Date

APR 27 1938 19

E. D. Hatfield

Scout