


Harvey

Section 19 Township 23 Range 3-W

Well No. 1 Dyck

Company T. C. Johnson

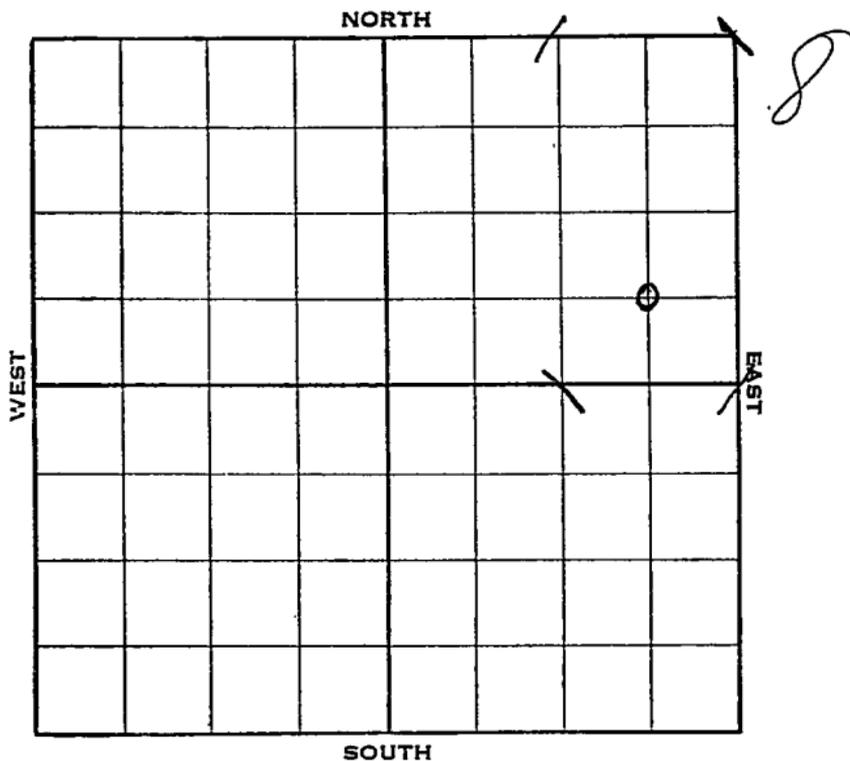

1938

8/10

7ⁿ - 3400'.

Chat. 3257'.

T. D. 3344'.

2000 acid.

P & F 16 bbls. 4 hrs. & 17 bbls.

4 hours.

Potential 100 bbls.

2000 acid.

No help.

Minimum well.

COMPLETED

Map No. 39 Sec. 19 Twp. 23 R. 3WWell No. 1 DyckT. C. Johnson Company

Contractor

FIRST REPORT

C SE NE

 Ft. from N. Line660 Ft. from S. Line660 Ft. from E. Line Ft. from W. Line

SECTION PLAT

			0

Location Rig up

Drilling and Remarks:

BRR

RECORD

Cased in., ft.Sand Gas Oil Total Depth

PRODUCTION

1st 24 hrs. Nat. 1st 24 hrs. after shot Gas Cu. Ft.Dry Hole Abandoned

Date

MAY 4 - 1938 19 H. D. Hatfield Scout

Harvey

Map No. 39 Sec. 19 Twp. 23 R. 3W

Well No. 1 Dyck

T. C. Johnson Company

Contractor

COMPLETED

SECTION PLAT

C SE NE

			0

_____ Ft. from N. Line

660 Ft. from S. Line

660 Ft. from E. Line

_____ Ft. from W. Line

Location _____

Rig up _____

Drilling and Remarks:

2000 acid
P. & F 16 1/4 & 17 1/4
POT 100 —
2000 Acid NO help
MIN. well

RECORD

Cased 7 in., 3400 ft.

Sand Chat 3257

Gas _____

Oil _____

Total Depth 3344

PRODUCTION

1st 24 hrs. Nat. _____

1st 24 hrs. after shot _____

Gas _____ Cu. Ft.

Dry Hole _____

Abandoned _____

Date

AUG 10 1938 19 H. D. Hatfield Scout