


Map No. **KANSAS** Sec. **19** Twp. **23** R. **3** Harvey
 Well No. **3-Krehbiel** Farm
Olsen & Shell Company

NORTH

WEST

EAST

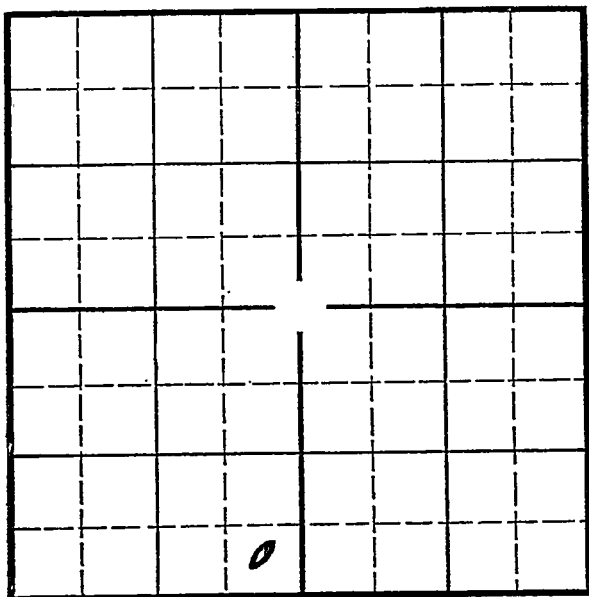

SOUTH

Location _____
 Drilling Remarks _____

Rig Up _____
 Drilling Remarks _____

RECORD

Cased _____ in. _____ ft.
 Sand _____
 Gas _____
 Oil _____
 Total Depth _____

PRODUCTION

1st 24 hrs. Nat. _____
 1st 24 hrs. after shot _____
 Gas _____ cu. ft. _____
 Dry Hole _____
 Abandoned _____


KANSAS

Map No. 19 Sec. 23 Twp. 30 R. 30

Well No. 3- Krehbiel Farm

Olson & Shell Company

NORTH

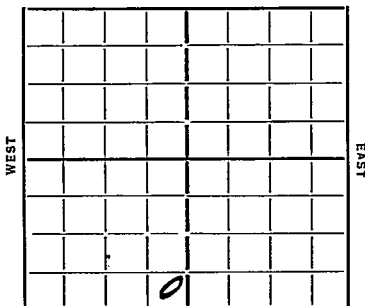

SOUTH

 Ft. from N. Line

330 Ft. from S. Line

330 Ft. from E. Line

 Ft. from W. Line

Elev. 1459

Date 12/3/5 REPORT

8/14 B. R.
8/22 Rig
8/29 H
9/6 Spud
10/3, 2725
10/10 TC 3253 TD 3268 7" 3266
10/24 TC 3253
TD 3364
1000 acib
225 lib
20 Water

COMPLETED

Map No. 39 Sec. 19 Twp. 23 R. 3W

Well No. 3-Krehbiel
Olsen & Shell Company

Contractor

FIRST REPORT

SECTION PLAT

Ft. from N. Line

330 Ft. from S. Line

330 Ft. from E. Line

Ft. from W. Line

FIRST REPORT

Location

Rig up

Drilling and Remarks:

Bed Rig

RECORD

Cased _____ in., _____ ft.

Sand _____

Gas _____

Oil _____

Total Depth _____

PRODUCTION

1st 24 hrs. Nat. _____

1st 24 hrs. after shot _____

Gas _____ Cu. Ft.

Dry Hole _____

Abandoned _____

Date

8-14-35 192

ORVAL MANNESMANN

Scout

KANSAS

Form 25-17-1-28

Map No. 39 Sec. 19 Twp. 23 R. 34Well No. 3-KrehbilOlsen & Shell Company

Contractor

COMPLETED

SECTION PLAT

Ft. from N. Line

330 Ft. from S. Line330 Ft. from E. Line

Ft. from W. Line

Location

Rig up

Drilling and Remarks:

1000 and225 oil
20 water

RECORD

Cased in, ft.

Sand TC 3253

Gas

Oil

Total Depth 3364

PRODUCTION

1st 24 hrs. Nat.

1st 24 hrs. after shot

Gas Cu. Ft.

Dry Hole

Abandoned

Date

10-24-35 192

ORVAL MANNSCHRECK

Scout