

Harvey

Form 51-5M-11-31-Palace

Map No. KANSAS Sec.

Twp. 19

23

R. 3^w

Well No.


1-94 Prehbil

Farm

Olsen Oil & Shell

Company

NORTH

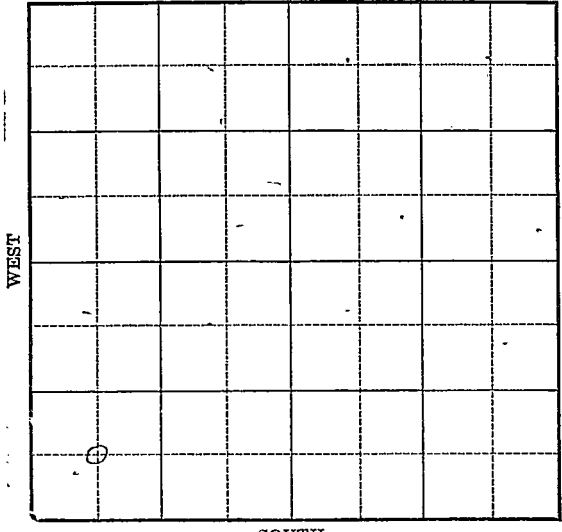

13

Location _____

Drilling Remarks _____

Rig Up _____

Drilling Remarks _____

RECORD

Cased _____ in. _____ ft.

Sand _____

Gas _____

Oil _____

Total Depth _____

PRODUCTION

1st 24 hrs. Nat. _____

1st 24 hrs. after shot _____

Gas _____ cu. ft.

Dry Hole _____

Abandoned _____

Map No. **KANSAS** Sec. 19 Twp. 23 R. 3^w

Well No. 1-J.J. Krebil Farm

Olsen Oil & Shell Company


_____ Ft. from N. Line

660 Ft. from S. Line

_____ Ft. from E. Line

660 Ft. from W. Line

1937

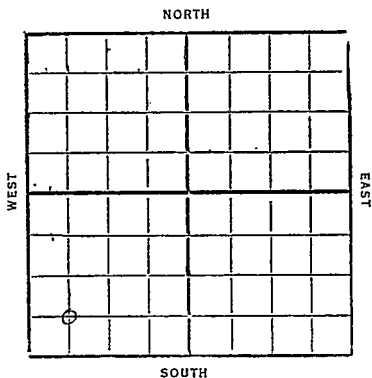

Date	REPORT
5/4	Mowing in mat
5/11	Curt
5/18	Drlg 1270
5/25	" 2347
6/1	" 3055
6/8	Top Chat 3269
	Cem 8"-3280 Bust
6/15	Drlg 3370 show oil
6/22	Cased 8"-3280
	Chat 3269-3373
	TD 3373
	flow 2 1/2 bbl oil
	1 ft gas
	Comp.

Harvey

39

KANSAS

Map No. _____ Sec. *19* Twp. *23* R. *3* ^W

Well No. *1* *J. J. Krehbiel*

Olsen Oil Co & Shell Company

Contractor _____

FIRST REPORTS

_____ Ft. from N. Line

660 Ft. from S. Line

_____ Ft. from E. Line

660 Ft. from W. Line

SECTION PLAT

Location _____

Rig up _____

Drilling and Remarks:

Drilling in Nat.

RECORD

Cased _____ in., _____ ft.

Sand _____

Gas _____

Oil _____

Total Depth _____

PRODUCTION

1st 24 hrs. Nat. _____

1st 24 hrs. after shot _____

Gas _____ Cu. Ft.

Dry Hole _____

Abandoned _____

Date

MAY 4 1932

CHAS. L. SHERWOOD

192 _____ Scout

Harvey

39 KANSAS

Map No. _____ Sec. 19 Twp. 23 R. 3 ^W

Well No. 1 *J. J. Krehbiel*

Olsen Oil Co & Shell Company

Contractor

COMPLETED

SECTION PLAT

_____ Ft. from N. Line

660 Ft. from S. Line

_____ Ft. from E. Line

660 Ft. from W. Line

0			

Location _____

Rig up _____

Drilling and Remarks:

Flow 218 Bbls

RECORD

Cased 8 in., 2780 ft.
 Sand Phot 3269-3373
 Gas _____
 Oil _____
 Total Depth 3373

PRODUCTION

1st. 24 hrs. Nat. _____
 1st. 24 hrs. after shot _____
 Gas 1 11 Cu. Ft.
 Dry Hole: _____
 Abandoned: _____

Date

JUN 22 1932 **CHAS. L. SHERWOOD**

192

Scout