

Harvey
23 30W

Map No. **KANSAS** Sec. 19 Twp. 23 R. 30W

Well No. L. Guldner Farm _____
Nye et al Company _____


_____ Ft. from N. Line

330 Ft. from S. Line

_____ Ft. from E. Line

330 Ft. from W. Line

Elev. 1460

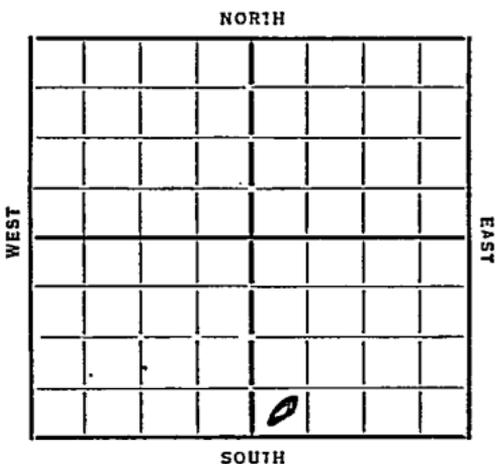

Date 1935

REPORT

8/14 Callar
8/22 Timbers
8/29 _____
9/6 Rig
9/14 Log Bit 225
10/3 _____
10/10 Log 450
11/1 " 2455 HF.W.
11/7 6" 2506 16 @ 2513
 HF.W 2765-75
 Log 2840
11/14 TD 2990 w 16"
11/21 _____
11/29 6" 2934 5" 3247 @ O.
12/6 Log Chat 3251 5" 3250
 Log 3292 Est 17M Gas.
12/13 T Chat 3251
 17M Gas 3259 to 3293
 Pay 3329-54 TD Swabbed 225 well
 24hrs with 17M Gas
 2500 acid wOA.

OVER

12/18 Chat 3250
TD 3354
2500 acid
312 Bbls.

COMPLETED

Map No. 39 Sec. 19 Twp. 23 R. 3W

Well No. 1 - Gulsner

Nye et al Company

Contractor

FIRST REPORT
~~COMPLETED~~ SECTION PLAT

..... Ft. from N. Line

330 Ft. from S. Line

..... Ft. from E. Line

330 Ft. from W. Line

FIRST REPORT

Location.....

Rig up.....

Drilling and Remarks:

cellar

RECORD

Cased..... in., ft.

Sand.....

Gas.....

Oil.....

Total Depth.....

PRODUCTION

1st 24 hrs. Nat.....

1st 24 hrs. after shot.....

Gas..... Cu. Ft.

Dry Hole.....

Abandoned.....

Date

8-14-35 192

ORVAL MANNSCHRECK

Scout

Map No. 39 Sec. 19 Twp. 23 R. 3W

Well No. 1 - Guldner
Nye et al Company

Contractor

SECTION PLAT

..... Ft. from N. Line

330 Ft. from S. Line

..... Ft. from E. Line

330 Ft. from W. Line

RECORD

Location.....

Rig up.....

Drilling and Remarks:

2500 and

312 bbls

Cased..... in., ft.

Sand Chert 3250

Gas.....

Oil.....

Total Depth 3354

PRODUCTION

1st 24 hrs. Nat.....

1st 24 hrs. after shot.....

Gas..... Cu. Ft.

Dry Hole.....

Abandoned.....

Date

12-18-35 192.....

ORVAL MANSCHRECK

Scout