




Map No. **KANSAS** Sec. 19 Twp. 23 R. 3<sup>W</sup>

Well No. 2-Krehbil Farm  
Olsen & Shell Company

660 Ft. from N. Line  
\_\_\_\_ Ft. from S. Line  
\_\_\_\_ Ft. from E. Line  
660 Ft. from W. Line

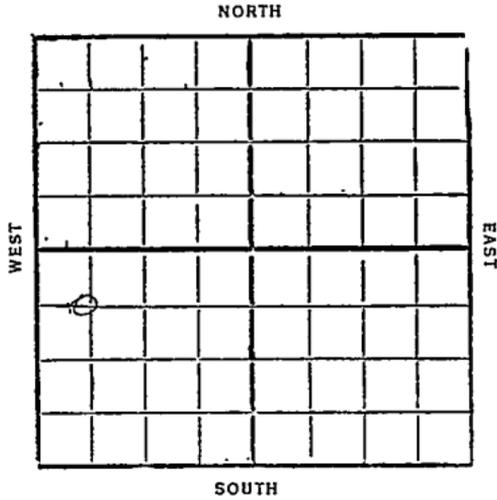

1932

Date	REPORT
7/27	Loc
8/3	—
8/10	—
8/17	—
8/24	—
8/31	—
9/7	—
9/14	—
9/21	—
9/30	—
10/5	—
10/12	—
10/19	Ford
10/26	Rig
11/2	—
11/9	—
11/16	—
11/23	—
11/30	—
12/7	Dry 150'
12/14	" 1730'
12/21	" 2865'

12/28 Top Chat 3257  
Rng 8" - 3287' T.D

1933

1/4- TD 3373

Est 8 to 10 bbls an hr

1/2 # gas

1/11- TD. 3373 Rng tubing

1/18- Chat 3257-3373

TD 3373

flow 120 bbl oil

350,000 ft gas

Comp.

Harvey

39 KANSAS Map No. Sec. 19 Twp. 23 R. 3 W

Well No. 2 Krehbiel  
Olsen & Shee Company

Contractor

FIRST REPORTS

660 Ft. from N. Line  
..... Ft. from S. Line  
..... Ft. from E. Line  
660 Ft. from W. Line

SECTION PLAT

0			

Location

Rig up .....

Drilling and Remarks: .....

RECORD

Cased..... in., ..... ft.

Sand.....

Gas.....

Oil.....

Total Depth.....

PRODUCTION

1st 24 hrs. Nat.....

1st 24 hrs. after shot.....

Gas..... Cu. Ft.

Dry Hole.....

Abandoned.....

Date

JUL 27 1932

CHAS. L. SHERWOOD

192

Scout

Harvey

39 KANSAS  
Map No. \_\_\_\_\_ Sec. 19 Twp. 23 R. 3<sup>W</sup>Well No. 2 Krehbiel  
Olsen & Sheer \_\_\_\_\_ Company\_\_\_\_\_  
Contractor**COMPLETED****SECTION PLAT**

660 Ft. from N. Line

\_\_\_\_\_ Ft. from S. Line

\_\_\_\_\_ Ft. from E. Line

660 Ft. from W. Line

0			

Location \_\_\_\_\_

Rig up \_\_\_\_\_

Drilling and Remarks:

Flow 120 Bbls Air

**RECORD**

Cased \_\_\_\_\_ in., \_\_\_\_\_ ft.

Sand 3257-3373

Gas \_\_\_\_\_

Oil \_\_\_\_\_

Total Depth 3373

**PRODUCTION**

1st 24 hrs. Nat. \_\_\_\_\_

1st 24 hrs. after shot \_\_\_\_\_

Gas 350,000 Cu. Ft.

Dry Hole \_\_\_\_\_

Abandoned \_\_\_\_\_

Date

JAN 1 8 1933<sub>192</sub>

CHAS. L. SHERWOOD

Scout