


Section 19 Township 23 Range 7W

Well Number 1 Page 1

Company Atlantic Refg.

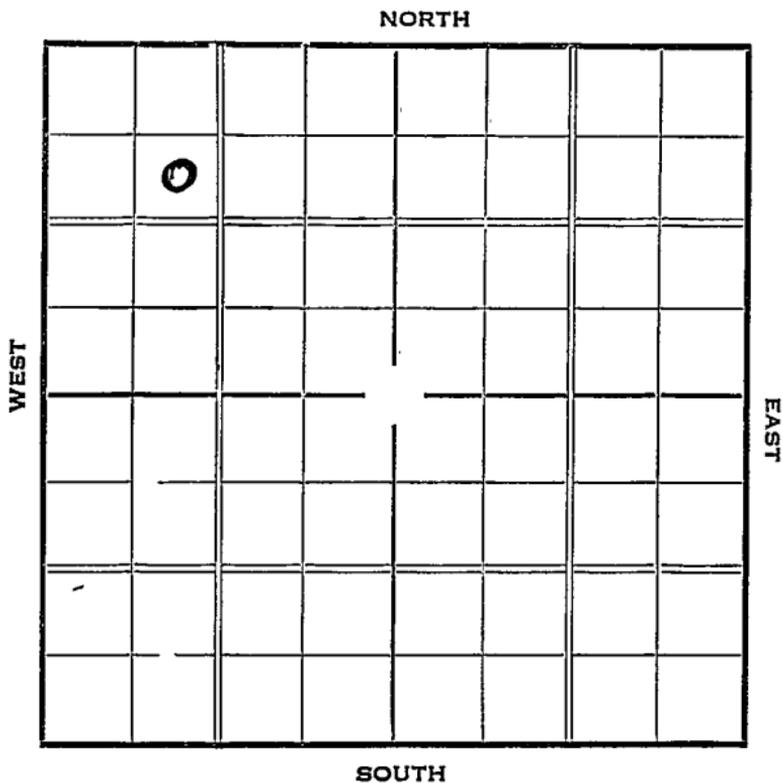

Sec. 19 Twp. 23 R. 7-W

Well No. #1 Page _____ Farm _____

Atlantic Ref. Company _____


990 Ft. from N. Line

_____ Ft. from S. Line

_____ Ft. from E. Line

990 Ft. from W. Line

Elev. 1615

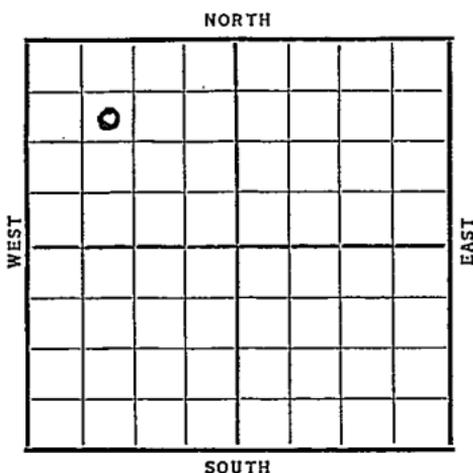

1937

REPORT

2/3 Location

2/11 Rig

2/18 Surface hole.

2/26 12" @ 172. Drlg. 2300'.

3/4 Topeka 2583'. Drlg. 3087'.

3/11 Lansing 3100' Chat ~~3655~~ 3675'

Coring 3664'.

3/18 Chat 3675' Corrected Set 8"

RUST

3/25 Fishing 3681'.

4/2 " " "

4/8 Drlg. 3745'

4/14 Sil. 4069'.

T.D. 4089'.

ABANDONED

Map No. 41 Sec. 19 Twp. 23 R. 7W

Well No. 1 Page

C. H. Hunter Ref Company
Contractor

SECTION PLAT

o			

990 Ft. from N. Line
_____ Ft. from S. Line
_____ Ft. from E. Line
990 Ft. from W. Line

FIRST REPORT

Location ✓

Rig up _____

Drilling and Remarks:

RECORD

Cased _____ in., _____ ft.

Sand _____

Gas _____

Oil _____

Total Depth _____

PRODUCTION

1st 24 hrs. Nat. _____

1st 24 hrs. after shot _____

Gas _____ Cu. Ft.

Dry-Hole _____

Abandoned _____

Date

FEB 3 1937

19

S. J. LEWIS

Scout

Map No. 41 Sec. 19 Twp. 23 R. 7W

Well No. 1 Page.

Atlantic Ref. Company

Contractor

SECTION PLAT

o			

990 Ft. from N. Line

_____ Ft. from S. Line

_____ Ft. from E. Line

990 Ft. from W. Line

ABANDONED

Location _____

Rig up _____

Drilling and Remarks:

Sil 40.69

RECORD

Cased _____ in., _____ ft.

Sand _____

Gas _____

Oil _____

Total Depth 4089

PRODUCTION

1st 24 hrs. Nat. _____

1st 24 hrs. after shot _____

Gas _____ Cu. Ft.

Dry Hole

Abandoned

Date

APR 14 1937 19

S. J. LEWIS Scout

