


Stafford

Section 19 Township 23 Range 11W

Well No. #2 Wendleburg

Company Carl Todd et al

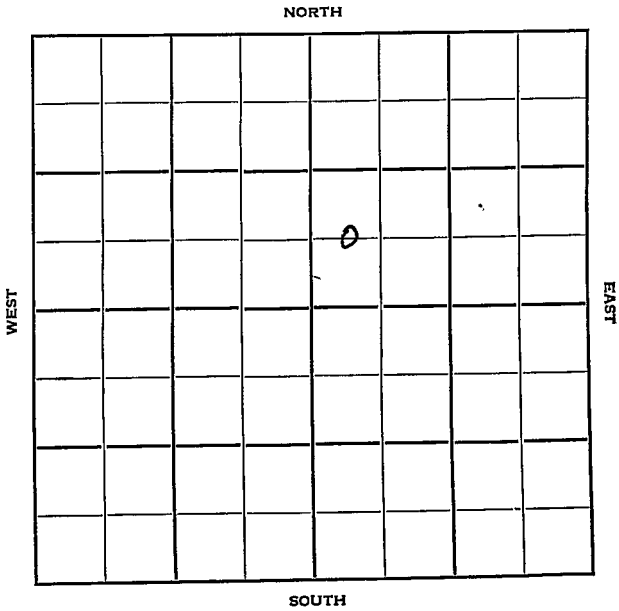

Sec. 19 Twp. 23 R. 11 W

Well No. # 2 Wendleburg Farm

Carl Todd et al Company

Carl Todd Contractor

Wendleburg


Ft. from N. Line

660 Ft. from S. Line

Ft. from E. Line

330 Ft. from W. Line

C W/2 SW NE

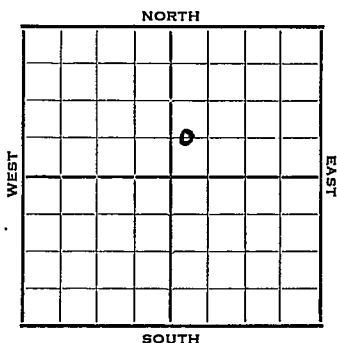

1952

Elev. 1820 REPORT

7/16  
7/23

Location  
8" @ 250'  
Anhy 570'  
Drlg. 1900'

7/30

Heeb. 3141 Br Li 3288  
Lans. 3314 BKG 3579  
V 3623 Simp. 3669  
Arb. 3726  
DST 3727-30 40 mins 33' wtr.  
2' SOCM 1050#  
Drlg. 3740'

8/6

Spd 7-18-52  
D&A TD 3765  
8" @ 250  
Anhy 570 Heeb. 3141  
Br Lime 3288 Lans. 3314  
BKG 3579 Viola 3623  
Simp 3669 Arb. 3726  
DST 3727-30 opn 40 min. Rec. 33' wtr.  
2' socm 1050# TD 3765 D&A

**ABANDONED**

County Stafford State Kansas

Sec. 19 (Blk. Twp.) 23 (Sur. Rge.) 11W Map No.

Operator Carl Todd et al.

Well No. 2 Farm Wendleburg

Elev. \_\_\_\_\_ Location C W/2 SW NE


660 Ft. From S Line NE

330 Ft. From W Line Quarter

1st. Report JUL 1 6 1952

Completion \_\_\_\_\_

Remarks \_\_\_\_\_

Carl Todd - Contr.

Spudding Date \_\_\_\_\_

Drlg. Data Wendleburg

Location

J. G. MCGEHEE

