


Section 19 Township 23 Range 11 W

Well No. # 1 Wendleberg "B"

Company Carl Todd Drlg

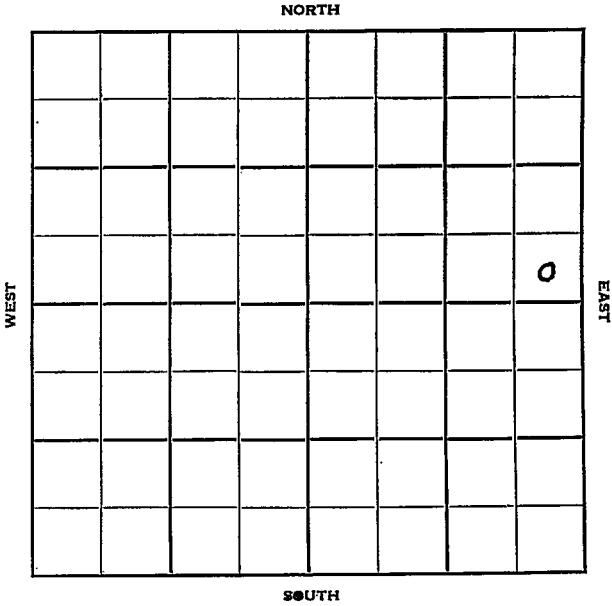

Sec. 19 Twp. 23 R. 11W

Well No. #1 Wendleberg "B" Farm

Carl Todd Drlg. Company

Todd Drlg. - Contr. Contractor

Wendleberg Pool


Ft. from N. Line

330' Ft. from S. Line

330' Ft. from E. Line

Ft. from W. Line

SE SE NE

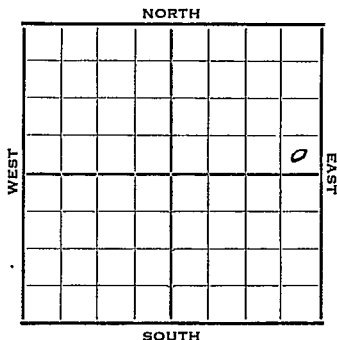

1952 Elev. 1830' REPORT

2/20 Spud 2-18-52
8" @ 246

3/5 WOC

Spud 2-18-52
 D&A TD 3785
 8" @ 246' Heeb. 3152 Tor. 3170
 Br. Li 3296 Lans. 3324
 B KC 3592 Marm. 3630
 Viola 3665 Simp. 3684
 Arb. 3742

DST 3743-48 open 45 min. rec. 130' SW
TD 3785 D&A

ABANDONED

County **Stafford** State **Kansas**

Sec. **19** (Blk. Twp.) **23** (Sur. Rge.) **11W** Map No.

Operator **Carl Todd Drlg.**

Well No. **1** Farm **Wendleberg "B"**

Elev. _____ Location **SE SE NE**

330 Ft. From **S** Line **NE**

330 Ft. From **E** Line Quarter

1st. Report **FEB 26 1952**

Completion _____

Remarks _____

Todd Drlg. - Contr.

Spudding Date **2-18-52**

Drlg. Data **Wendleberg Pool**

8" @ 246 WOG

FIRST REPORT

