


Section 19 Township 23 Range 12 W

Well No. # 1 Meyer

Company Petroleum Inc.

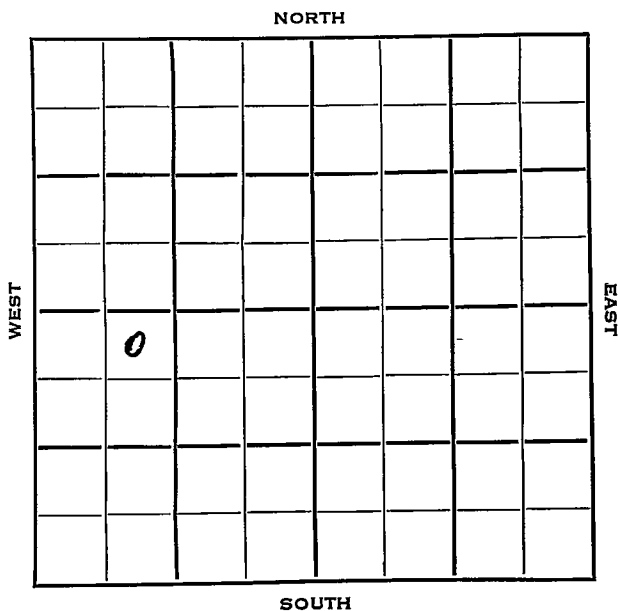

Stafford KANSAS


SEC.	TWP.	R.
19	23	12W

WELL NO. \_\_\_\_\_  
 1 Meyer FARM  
 COMPANY

Petroleum, Inc.  
 CONTRACTOR

Petroleum, Inc.  
 Wildcat

330 \_\_\_\_\_ Ft. from N. Line  
 \_\_\_\_\_ Ft. from S. Line  
 \_\_\_\_\_ Ft. from E. Line  
 990 \_\_\_\_\_ Ft. from W. Line

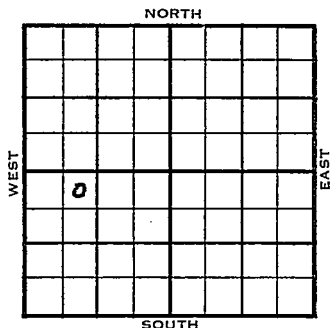

NE NW SW

1953	ELEVATION 1878'	REPORT
------	--------------------	--------

11/24 Spud 11-22-53  
 8" @ 233, WOC

12/9 Spud 11-22-53  
 D&A  
 TD 3916  
 8" @ 233'  
 Heeb 3277', Br lime 3415', ans 3440'  
 DST 3452-92, opn 1 hr., rec. 35' mud  
 DST 3491-3525', opn 1 hr., reec. 110'  
 mud, 925#  
 DST 3566-80', opn 45 mins., rec. 30'  
 wtr, 125#  
 DST 3580-3648', opn 1 hr., rec. 70'  
 mud, 850#  
 Cong 3716'  
 DST 3664-3752', opn 1 hr., rec. 30'  
 mud, 0#  
 Viola 3758', Simp 3824'  
 DST 3854-69', opn 1/2 hrs., rec. 12'  
 mud 0#  
 Arb. 3910'  
 DST 3912-16', opn 1 hr., rec. 420'  
 wtr, 1125#  
 TD 3916  
 D&A

ABANDONED



