

Section 19 Township 23 Range 13W

Well No. #1 Brenn

Company Heathman & Seeligson

NORTH

WEST

EAST


			0				

SOUTH

Stafford KANSAS

SEC.	TWP.	R.
19	23	13W ✓
WELL NO.		
1 Brenn		FARM
COMPANY		
Heathman & Seeligson		
CONTRACTOR		
Co. Tools		

330 _____ Ft. from N. Line
 _____ Ft. from S. Line
 330 _____ Ft. from E. Line
 _____ Ft. from W. Line

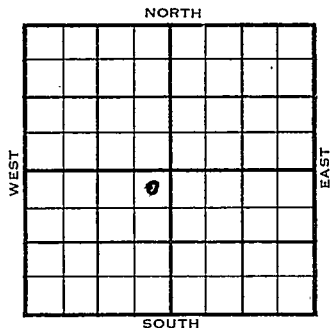

NE NE SW

Stanolind Farmout & DHM

	ELEVATION	REPORT
1954	1925'	
4/14 5/19	MIR Spud 4-13-54 Oil Well TD 4015' 8" @ 240' Anhy 812', Heeb 3372', Br. Lime 3507' Lans 3532' DST 3580'-3605' opn 1 hr, rec 180' gas, 150' so & gcsw, 1110# DST 3645'-57' opn 1 hr, rec 720' gco 180' mco, 1225# DST 3694'-3703' opn 3/4 hr, rec 12' wcm 1125# DST 3713'-25' opn 1 hr, rec 50' wcm, Cong 3848' Viola 3877', Simp 3938' Arb 3991' TD 4015' 5" @ 3760' perf 3697-3702 1000 A S/ 5 bfph 3 hr 40% Wtr. S/ 3 1/2 bfph 12hr. 35% Wtr. 2500 A 4 1/2 bfph 25% Wtr. 18 hr. PB 3680' 32/ 3651-57 S/ 1/2 boph 4 hr. 500 A F/ 28 boph 2 hr. SI 12 hr. F/ 42 boph 1 hr. Comp F/ 153 bopd.	3991 1925 2066

COMPLETED

3991
1925
2066

COMPLETED

County **Stafford** State **Kansas**

Sec. 19 (Blk. Twp.) 23 (Sur. Rge.) 13W Map No.

Operator **Heathman & Seeligson**

Well No. **1** Farm **Brenn**

Elev.	Location	NE NE SW
-------	----------	----------

FIRST REPORT

330 Ft. From N Line SW

330	Ft. From	E. Line	Quarter

1st. Report **APR 1, 4 1954**

Completion _____

Remarks	Stanolind farmout & Co. tools	DEM
---------	----------------------------------	-----


Spudding Date _____

Drlq. Data

M I R

J. G. McGEHEE

County Stafford State Kansas
 Sec. 19 (Blk. 23) (Sur. 13W) Map No.
 Operator Heathman & Seeligson
 Well No. 1 Farm Brenn
 Elev. 1925 Location E NE NE SW

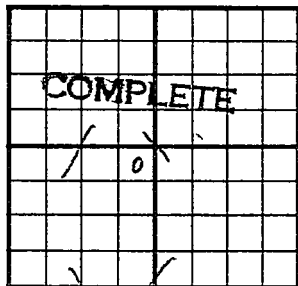

330 Ft. From N Line SW
330 Ft. From E Line Quarter
 Ist. Report
 Completion MAY 19 1954
 Remarks Brenn Pool
Co. tools
 Spudding Date 4-13-54

Drlg. Data Oil well TD 4015

8" @ 240 Anhy 812 Heeb. 3372

Br. lime 3507 Lans. 3532 DST 3580-3605

open 1 hr. Rec. 180' gas 150' so & gcsw

1110# DST 3645-57 open 1 hr. Rec.

720' gco 180' mco 1225# DST 3694-

3703' open 3/4 hr. Rec. 12' wcm 1125#

DST 3713-25 open 1 hr. Rec. 50' wcm

Cong. 3848 Viola 3877 Simp. 3938

Arb. 3991 TD 4015 5" @ 3760

perf/ 3697-3702 1000 A S/ 5 bfph 3 hr.

40% wtr. S/ 3 1/2 bfph 12 hr. 35% wtr.

2500 A 4 1/2 bfph 25% wtr. 18 hr.

PB 3680 32/ 3651-57 S/ 1/2 boph 4 hr.

500 A F/ 28 boph 2 hr. SI 12 hr.

J. G. McGEHEE

Drlg. Data

F/ 42 boph 1 hr. Comp. F/ 153 bopd

Scout Cards
Land Control Map
Land Well Map
Tracing
French
Plan & Map
Notes

MAY 24 1954