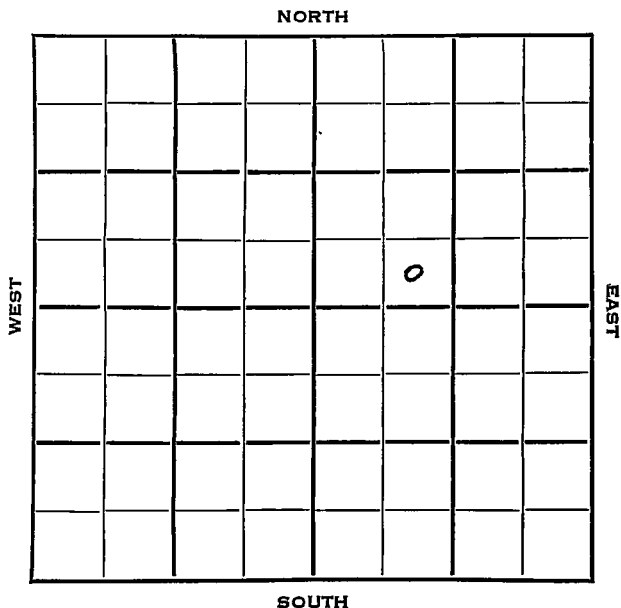


Section 19 Township 23 Range 15WWell No. 1 O. P. McComas "B"Company Stanolind

Dawnee

KANSAS

SEC.	TWP.	R.
19	23	15W

WELL NO.

#1 O.P. McComas "B"

FARM

COMPANY

Stanolind

CONTRACTOR

Benson Pool

Ft. from N. Line


330

Ft. from S. Line

Ft. from E. Line

990

Ft. from W. Line

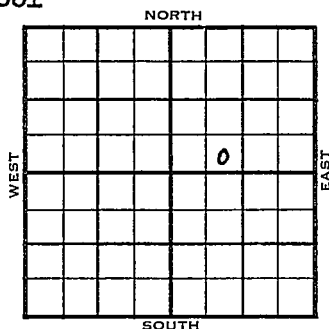


SE SW NE

1953	ELEVATION	REPORT
	2044'	
11/4	Location	
11/11	8" @ 378' w/200 sks Drlg 3145'	
11/18	Lans 3641' DST 3658'-74' $\frac{1}{2}$ hr, 25' M 1010# Cong 3935', V 4007', Simp 4055, Arb 4088' DST 4088'-4100' 25 mins, 2,340,000 gas per day, 25' M 1310# Schl RTD 4150'	
12/2	Spud 11-2-53 Gas well TD 4150' 8-5/8" @ 378 Lans. 3641' DST 3658-74 open $\frac{1}{2}$ hr rec 25' mud 1010# Cong. 3935 Viola 4007' Simp. 4055' Arb. 4088' DST 4088-4100 open 25 min, 2,340,000 gas per day, 25' mud 1310# TD 4150 CO to 4126 32/4088-96 1000 A Comp. shut in gas well. 10,200,000 CFGPD	
COMPLETED		

J. G. McGEHEE

County Pawnee State Kansas
 Sec. 19 (Blk. Twp.) 23 (Sur. Rge.) 15W Map No. _____
 Operator Stanolind
 Well No. 1 Farm O. P. McComas "B"
 Elev. 2044 Location SE SW NE

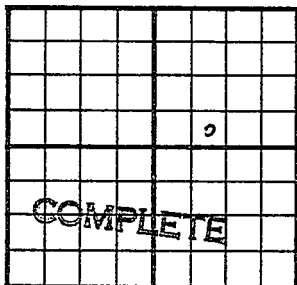

330 Ft. From S Line NE
990 Ft. From W Line Quarter
 Ist. Report _____
 Completion DEC 2 1953
 Remarks Benson Pool

Spudding Date 11-2-53

Drlg. Data Gas well TD 4150
8 5/8" @ 378 Lans. 3641 DST 3658-74
open 1/2 hr. Rec. 25' mud 1010#
Cong. 3935 Viola 4007 Simp. 4055
Arb. 4088 DST 4088-4100 open 25 min.
2,340,000 gas per day 25' mud 1310#
TD 4150 CO to 4126 32/ 4088-96
1000 A Comp. shut in gas well
10,200,000 cfcpd

J. G. McGEHEE