Pawnee KANSAS

SECTION 19 TOWNSHIP 23 RANGE 17W

WELL NO. #5 Shoemake

COMPANY Hilton Drlg. Co.

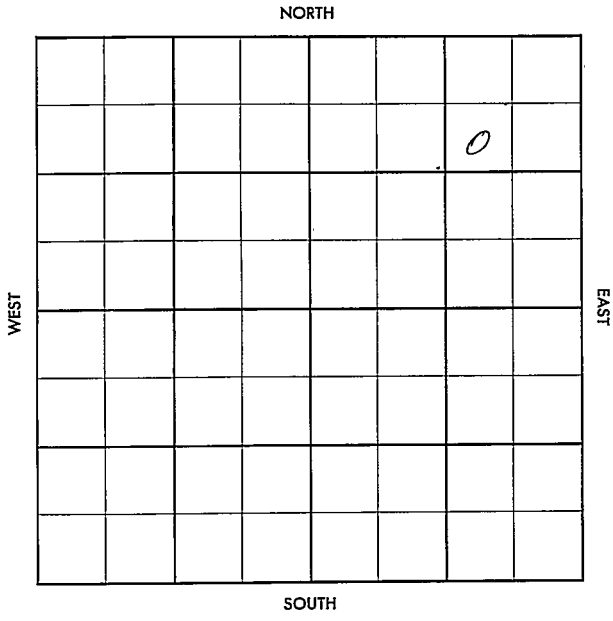


FORM 504-3 SUNRAY

Pawnee KANSAS

| SEC. | TWP. | R. |
|---|---|---|
| 19 | 23 | 17W |

WELL NO. #5 Shoemake FARM

COMPANY Hilton Drlg Co.

CONTRACTOR Co Tools

Garfield

_____ FT. FROM N. LINE

_____ FT. FROM S. LINE

_____ FT. FROM E. LINE

_____ FT. FROM W. LINE

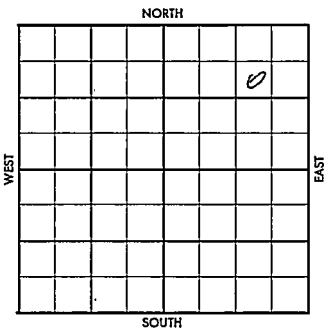


SW NE NE

| 1956 ELEVATION | REPORT |
|---|---|
| 9-5 | Comm 8-29-56<br>8" @ 238 w/200<br>Anh 1130<br>Drlg 3485 |

FORM 504-5 SUNRAY

FORM 513 SUNRAY

County Pawnee Elev.

Sec. 19 Twp. 23 Rge. 17W

Company Hilton Drlg. Co.

Farm Name Shoemake No. 5

| TOPS | DEPTH | LOG | DATUM |
|---|---|---|---|
| Anh. | 1130 | | |
| Tp. | | | |
| H. | | | |
| Tr. | | | |
| Dg. | | | |
| B.L. | | | |
| L. | | | |
| K.C. | | | |
| B.K.C. | | | |
| Ce. | | | |
| C. | | | |
| M. | | | |
| M. | | | |
| K. | | | |
| Mz. | | | |
| Mo. | | | |
| V. | | | |
| S. | | | |
| S. | | | |
| A | | | |
| R. | | | |
| P€. | | | |
| G. | | | |
| T.D. | | | |

Loc. in Sec. SW NE NE

Geol.

Contr. Co. Tools

Pool Garfield

FIRST REPORT

SEP 5 '56

Date Comm. 8/29/56

8"@ 238 w/200 Drlg. 3485

Co. Lse. No. Sec. T. R.

FORM 513 SUNRAY

County Pawnee Elev. [illegible]

Sec. 19 Twp. 23 Rge. 17

Company Hilton Drlg. Co.

FarmName Sheenake No. 5

| TOPS | DEPTH | LOG | DATUM |
|---|---|---|---|
| Anh. | 1130 | | |
| Tp. | | | |
| H. | 3686 | | |
| Tr. | | | |
| Dg. | | | |
| Bl. | 3793 | | |
| L. | 3801 | | |
| K.C. | | | |
| B.K.C. | | | |
| Ce. chert/cg | 4244 | | |
| C. sh | 4232 | | |
| M. | 4264 | | |
| M. | | | |
| K. | | | |
| Mz. | 4310 | | |
| Mo. | | | |
| V. | | | |
| S. | | | |
| S. | | | |
| A. | | | |
| R. | | | |
| P€. | | | |
| G. | | | |
| T.D. | 4350 | | |

Loc. in Sec. SW NE NE

Geol.

Contr. Co. To. 15

Pool Garfield

COMPLETE

OCT 31 '56

Date Comm. 8/29/56

Bll. 238 w/200 Drlg. 3485 SEP 12 '56

DST 4242-58 90" G/4" rec 2000' oil + 400' VHO & GCM FP 78-530 BHP Failed DST 4259-77 gr 90" rec 180' Mdy oil FP 28-90 BHP 1220/30 5 1/2 4348/150 SEP 19 '56 SEP 26 '56

OCT 3 '56 30/4246-50 Frac $ 14 Boph + 3% wtr OCT 10 '56 Po P OCT 17 '56

Wo Fut OCT 24 '56 OCT 31 '56 Ph P. 247 Bopd

Co. Lse. No. Sec. T. R.