

SECTION 19 TOWNSHIP 23 RANGE 17W


WELL NO. #8 Shoemake

COMPANY Hilton Drlg. Co.

NORTH

~~E/2 E/2 NE~~  
~~NE SE~~

WEST

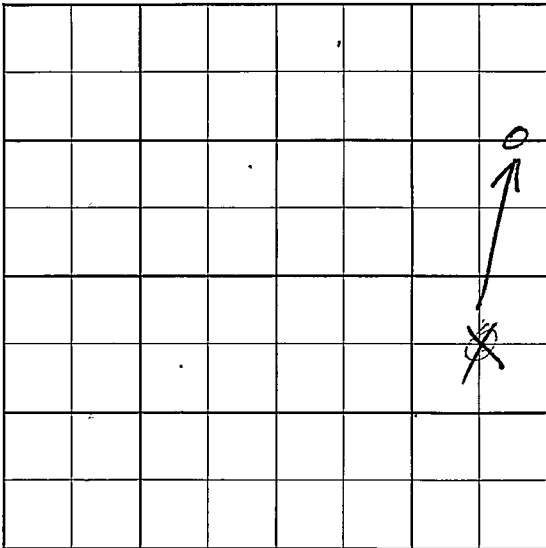

SOUTH

County Pawnee Elev. \_\_\_\_\_  
 Sec. 19 Twp. 23 Rgs. 17W  
 Company Hilton Dlr. Co.  
 FarmName Shoemake No. 8

| TOPS   | DEPTH | LOG | DATUM |
|--------|-------|-----|-------|
| Anh.   |       |     |       |
| TP.    |       |     |       |
| H.     |       |     |       |
| Tr.    |       |     |       |
| Dg.    |       |     |       |
| Bl.    |       |     |       |
| L.     |       |     |       |
| K.C.   |       |     |       |
| B.K.C. |       |     |       |
| Ce.    |       |     |       |
| C.     |       |     |       |
| M.     |       |     |       |
| M.     |       |     |       |
| K.     |       |     |       |
| Mz.    |       |     |       |
| Mq.    |       |     |       |
| V.     |       |     |       |
| S.     |       |     |       |
| S.     |       |     |       |
| A.     |       |     |       |
| R.     |       |     |       |
| PE.    |       |     |       |
| G.     |       |     |       |
| T.B.   |       |     |       |

Loc. in Sec. NE SE  
 Geol. \_\_\_\_\_  
 Contr. \_\_\_\_\_  
 Co. Tools \_\_\_\_\_  
 Pool Garfield  
 FIRST REPORT  
 APR 24 57

Date Comm. MIRT

*[Handwritten signature/initials]*

Co.  
Lse.  
No.  
Sec.  
T.  
R.

# CORRECTION

FORM 513 SUNRAY

County Pawnee Elev. 2099  
 Sec. 19 Twp. 23 Rge. 17W  
 Company Hilton Dlr. Co.  
 Farm Name Shoemaker No. 8

| TOPS              | DEPTH       | LOG | DATUM | Loc. in Sec.   |          |  |           |          |
|-------------------|-------------|-----|-------|--|----------|--|-----------|----------|
| Anh.              | <u>1135</u> |     |       | <u>NE-SB</u>   |          |  |           |          |
| TP.               |             |     |       | <u>E2E2NE</u>  |          |  |           |          |
| H.                | <u>3686</u> |     |       |  |          |  |           |          |
| Tr.               |             |     |       |  |          |  |           |          |
| Dg.               |             |     |       |  |          |  |           |          |
| Bl.               | <u>3794</u> |     |       |  |          |  |           |          |
| L.                |             |     |       |  |          |  |           |          |
| K.C.              | <u>3802</u> |     |       | Geol.  |          |  |           |          |
| BKC.              |             |     |       | Contr.   |          |  |           |          |
| Ce.               |             |     |       | Co. Tools  |          |  |           |          |
| C. <u>shly</u>    | <u>4228</u> |     |       | Pool   |          |  |           |          |
| M. <u>sq bher</u> | <u>4239</u> |     |       | <u>Garfield</u>  |          |  |           |          |
| M.                | <u>4260</u> |     |       | <table border="1"> <tr> <td colspan="2">COMPLETE</td> </tr> <tr> <td>AUG 28 57</td> <td><u>K</u></td> </tr> </table> | COMPLETE |  | AUG 28 57 | <u>K</u> |
| COMPLETE          |             |     |       |  |          |  |           |          |
| AUG 28 57         | <u>K</u>    |     |       |  |          |  |           |          |
| K.                |             |     |       |  |          |  |           |          |
| Mz.               |             |     |       |  |          |  |           |          |
| Mo.               |             |     |       |  |          |  |           |          |
| V.                |             |     |       |  |          |  |           |          |
| S.                |             |     |       |  |          |  |           |          |
| S.                |             |     |       |  |          |  |           |          |
| A.                |             |     |       |  |          |  |           |          |
| R.                |             |     |       |  |          |  |           |          |
| PE.               |             |     |       |  |          |  |           |          |
| G.                |             |     |       |  |          |  |           |          |
| TD.               | <u>4360</u> |     |       |  |          |  |           |          |

Date Comm.

MIRT MAY 1 57 A-22-57 85/8 215  
 1200 @ 3625 MAY 2 57 DST 4228  
 -51' 30" G/1" ga 3.550 MCF  
 rel. 140' GCM BHP 730/30"  
 FP 120-220 DST 4260-78  
 30" G/30" no ga rel. 70' 56CM  
 BHP 580/30" 5 1/2 4358/100  
 MAY 15 57 MAY 22 57 CO 4338.56/4280-86  
 no show @ 7st 550 + est 800 MCF

Frac  $\frac{1}{8}$  150 BF (mostly  
 wtr) +  $1\frac{1}{2}$  Mill CEG PD  
 CP 150# ga 1.250 MCFW  
 CP 650# TP 540# BTU

947 <sup>MAY 29 '57</sup> Killed well

CO 4360 36/4310-16

Flwd. 38 BF 32% wtr

$\frac{1}{2}$  + s + g. JUN 5 '57 communicated  
 + std  $1\frac{1}{2}$  Boph 35% wtr  
 + ga 1.250 MCFW PD T.C.R

JUN 12 '57 JUN 19 '57 JUN 23 '57 JUL 3 '57 JUL 10 '57 MICT

CO 4360 500. 211 PF15

JUL 17 '57 CO 4300 36/4280-86

$\frac{1}{2}$  Failed 36/4268-74  $\frac{1}{2}$

wouldn't take 36/4262-68

$\frac{1}{2}$  B 20 Goph 50% Acid  
 wtr Frac  $\frac{1}{8}$  10 Boph nolw

PB 4256 36/4242-48 G50

$\frac{1}{2}$  Flwd 5 Boph nolw  
<sup>JUL 24 '57</sup>

Flwd 1.12 Boph 25% wtr

TO POP <sup>JUL 31 '57</sup> <sup>AUG 8 '57</sup> <sup>AUG 14 '57</sup> <sup>AUG 21 '57</sup>  
<sup>AUG 28 '57</sup> Ph P. 22 Bopd + 70

% wtr