

Pawnee


KANSAS

DX 78-1

Section 19 Township 23 Range 17W

Well No. #6 Shoemake

Company Hilton Drlg.

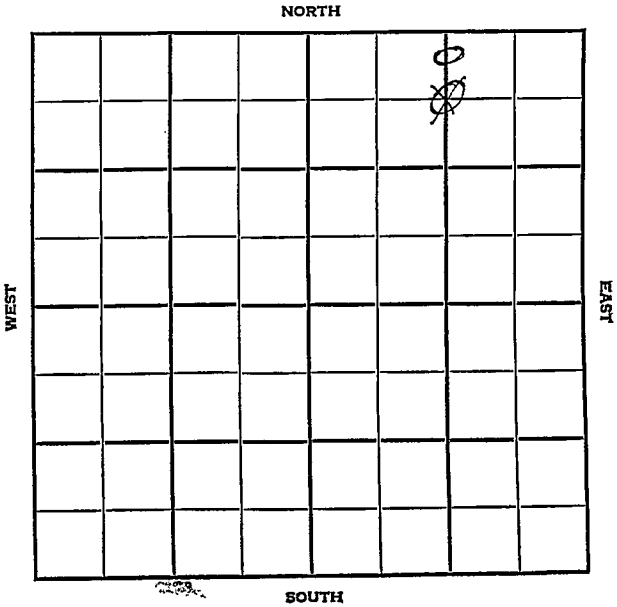

County Parmer Elev. _____
 Sec. 19 Twp. 23 Rge. 17W
 Company Hilton Drlg.
 FarmName Shoemake No. 6

| TOPS | DEPTH | LOG | DATUM | Loc. in Sec. |
|--------|-------|-----|-------|------------------|
| Anb. | | | | <u>C N/2NE/4</u> |
| TP. | | | | |
| H. | | | | |
| Tr. | | | | |
| Dg. | | | | Geol. _____ |
| Bl. | | | | Contr. _____ |
| L. | | | | <u>Co. Tools</u> |
| K.C. | | | | <u>Pool</u> |
| B.K.C. | | | | <u>Garfield</u> |
| Ce. | | | | |
| C. | | | | |
| M. | | | | |
| M. | | | | |
| K. | | | | |
| Mz. | | | | |
| Mo. | | | | |
| V. | | | | |
| S. | | | | |
| S. | | | | |
| A. | | | | |
| R. | | | | |
| PE. | | | | |
| G. | | | | |
| T.D. | | | | |

Date Comm. MIRT

APR 15 1956

[Handwritten signature and scribbles]

Co.
Lsc.
No.
Sec.
T.
R.

CORRECTION


FORM 513 SUNRAY

County Pawnee Elev. 2101
 Sec. 19 Twp. 23 Rge. 17W
 Company Hilton Drlg.
 Farm Name Shoemaker No. 6

| TOPS | DEPTH | LOG | DATUM |
|--------|---------------|-----|-------|
| Anb. | 1130 | | |
| Ip. | | | |
| H. | 3696 | | |
| Tr. | | | |
| Dg. | | | |
| Bl. | 3803 | | |
| L. | 3811 | | |
| K.C. | FT SCT 4244 | | |
| B.K.C. | | | |
| Ce. | | | |
| C. | SOLY 4253 | | |
| M. | cg chert 4266 | | |
| M. | * 4287 | | |
| K. | | | |
| Mz. | | | |
| Me. | | | |
| V. | | | |
| S. | | | |
| S. | | | |
| A. | | | |
| R. | | | |
| PE. | | | |
| G. | | | |
| TD. | 4411 | | |

Lot in Sec. C-11/2NE/4
N2 N2 NE4

Geol. _____
 Contr. _____
 Co. Tools _____
 Pool _____
 Garfield

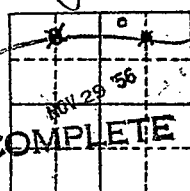

Date Comm.

MIRT OCT 24 '56 10-17-56 878
 243/200 M 2994 D 3350
 OCT 31 '56 DET 4251-75 op. 90" rec.
 660' oil & Mdy oil FP 50-230
 BHP -1230 Rng 5 1/2 @ OCT 7 '56 X
 5 1/2 @ 4390/150 MICT CO
 PF 12/3 268-71 16/4274-78 tstg
 NOV 13 '56 FU 54 BO 1/4 frac \$
 21 BF (590 wts) 16m tstg NOV 23 '56 T&P
 NOV 28 '56 Ph P. 165 Bopd 2700 wts

Co. Lse. No. Sec. T. R.