


DX 78-1

Section 19 Township 23 Range 32W
 Well No. 1 Frazier Gas Unit
 Company Stanolind

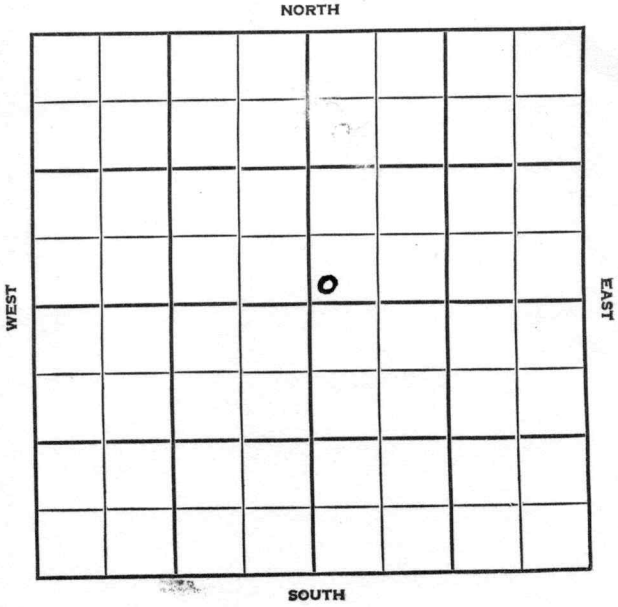

Finney KANSAS

SEC.	TWP.	R.
19	23	32W

WELL NO. 1 Frazier Gas Unit FARM

COMPANY Stanolind

CONTRACTOR

Hugoton Pool

Ft. from N. Line

150


Ft. from S. Line

Ft. from E. Line

150

Ft. from W. Line

SW SW NE

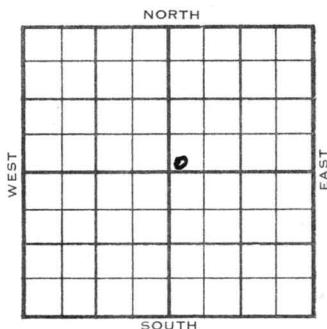

1954	ELEVATION	REPORT
	2875'	

7/28

Spdg 7-25-54

8" @ 976

WOC

8/18

Spud 7-25-54 Gas well TD 2627

8" @ 976 Her-Kri 2524 Win. 2595

TD 2627 5" @ 2595 CO to 2627

SSG A-frac 328,000 CFG 200 GW

90/2536-51 24/2553-57 24/2516-70

268,000 CFG A-frac 2,808,000 CFG

15 GAWPH

Comp. open flow 4,668,000 CFGPD 390#

COMPLETED

County **Finney** State **Kansas**

Sec. **19** (Blk. **23** (Sur. **32W** Map No.

Operator **Stanolind**

Well No. **1** Farm **Fraser Gas Unit**

Elev.	Location	SW	SW	NE
-------	----------	----	----	----

FIRST REPORT

150 Ft. From S Line NE

150 Ft. From W Line Quarter

1st. Report JUL 28 1954

Completion

Remarks.

Spudding Date 7-25-54

Drlg. Data Hugoton Pool

8th @ 976 WOC

J. G. McGEHEE


County Finney State Kansas

Sec. 19 (Blk.) 23 (Sur.) 32W Map No.

Operator Stanolind

Well No. 1 Farm Frazier Gas Unit

Elev. 2875 Location SW SW NE

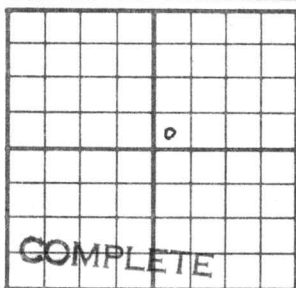

150 Ft. From S Line NE

150 Ft. From W Line Quarter

1st. Report

Completion AUG 18 1954

Remarks Hugoton Pool

Spudding Date 7-25-54

Drlg. Data Gas well TD 2627

8" @ 976 Her-Kri 2524 Win. 2595

TD 2627 5" @ 2595 CO to 2627

SSG A-frac 328,000 cfg 200 gw

90/ 2536-51 24/ 2553-57 24/ 2516-70

268,000 cfg A-frac 2,808,000 cfg

15 gawph Comp. open flow 4,668,000 cfgpd

390#

FABEN GILSTRAP