


Section 19 Township 23 Range 33-W

Well No. #1 Garden City Gas Unit

Company Stanolind

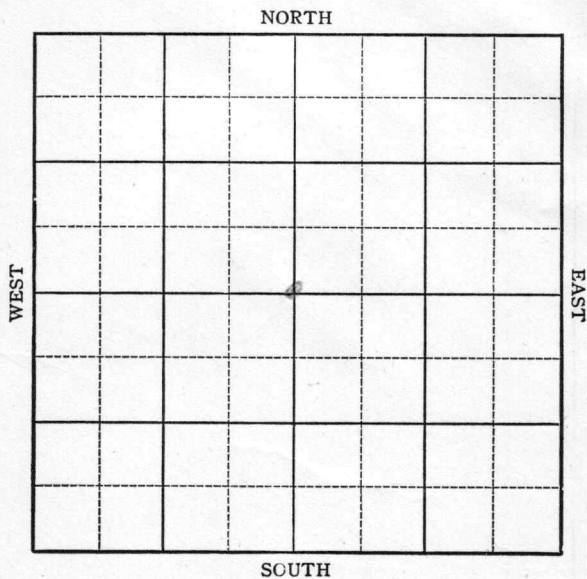

KANSAS

Finney County



Sec. 19 Twp. 23 R. 33W

Well No. #1 ~~#2~~ Garden City Gas Unit Farm

Stanolind Company

Hugoton


2640 Ft. from N. Line

 Ft. from S. Line

2640 Ft. from E. Line

 Ft. from W. Line

C Sec.

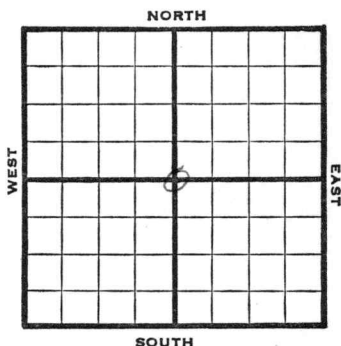

1946

2911

REPORT

7/31

Location

8/6

Surface hole

8/13

8" @ 979
Drlg 2185'

8/20

TD 2679
5" @ 2642 RUST

8/27

" "

9/5

" "

9/10

66 shots 2531-42
77 shots 2516-21
14000 acid

9/18

" "

9/25

5" @ 2642'
Perf
18,000 Acid
2,400,000 Gas
TD 2679'
RPR 406#

COMPLETED

~~KANSAS~~ Kansas Pool Name Hugoton

Map No. _____ Sec. 19 Twp. 23 R. 33W

Well No. 2 Garden City Gas Unit

Stanolind Company

FIRST REPORT Contractor

C SEC.


SECTION PLAT

2640 Ft. from N. Line

_____ Ft. from S. Line

2640 Ft. from E. Line

_____ Ft. from W. Line

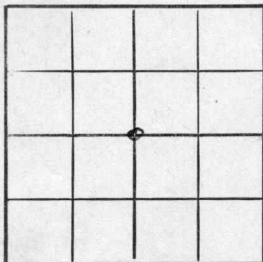

Finney County

Location X

Rig up _____

Drilling and Remarks:

RECORD

Cased _____ in., _____ ft.

Sand _____

Gas _____

Oil _____

Total Depth _____

PRODUCTION

1st 24 hrs. Nat. _____

1st 24 hrs. after shot _____

Gas _____ Cu. Ft.

Dry Hole _____

Abandoned _____

Date

JUL 3 1 1946 19

S. J. LEWIS Scout

~~KANSAS~~~~Kansas~~Pool Name HugotonMap No. _____ Sec. 19 Twp. 23 R. 33WWell No. 1 Garden City Gas UnitStanolind


Company

CORRECTION

Contractor

C Sec.

SECTION PLAT

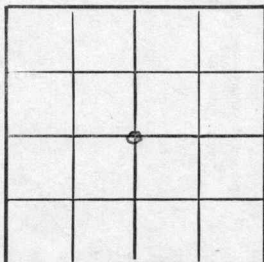2640 Ft. from N. Line

Ft. from S. Line

2640 Ft. from E. Line

Ft. from W. Line

Finney County

Location

Rig up

Drilling and Remarks:

Reported as
#2 Garden City
Gas Unit

correct from #251

RECORD

Cased _____ in., _____ ft.

Sand _____

Gas _____

Oil _____

Total Depth _____

PRODUCTION

1st 24 hrs. Nat. _____

1st 24 hrs. after shot _____

Gas _____ Cu. Ft.

Dry Hole _____

Abandoned _____

Date

AUG 7 194619S. J. LEWIS

Scout

KANSAS

Kansas


Pool Name Hugoton PoolMap No. _____ Sec. 19 Twp. 23 R. 33WWell No. 1 Garden City Gas UnitStanolind

Company

COMPLETED

Contractor

C Sec.

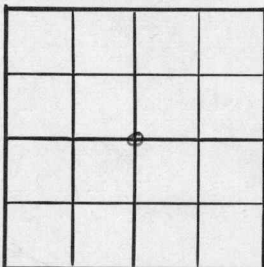E12911
SECTION PLAT2640 Ft. from N. Line

_____ Ft. from S. Line

2640 Ft. from E. Line

_____ Ft. from W. Line

Finney County

Location _____

Rig up _____

Drilling and Remarks:

5-702642Perf.18000 and2,400,000 Gas406 #R/R**RECORD**

Cased _____ in., _____ ft.

Sand _____

Gas _____

Oil _____

Total Depth 2679**PRODUCTION**

1st 24 hrs. Nat. _____

1st 24 hrs. after shot _____

Gas _____ Cu. Ft.

Dry Hole _____

Abandoned _____

Date

SEP 25 1946

19

S. J. LEWIS

Scout