

Harvey KANSAS

Section 2 Township 23 Range 3WWell No. #1 SchragCompany Geo. Seigrist

Stuckey Pool

NORTH

0							

WEST

EAST

SOUTH

Harvey KANSAS

Sec. 2 Twp. 23 R. 3W ✓

Well No. #1 Schrag Farm

Geo. Seigrist Company

Stuckey Pool


330' Ft. from N. Line

_____ Ft. from S. Line

_____ Ft. from E. Line

330' Ft. from W. Line

NW SW

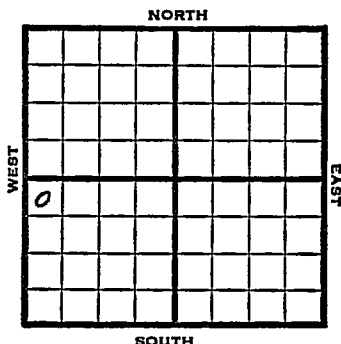

1949

Elev. 1437' REPORT

12/21

8" @ 805'

12/28

Dr1g 1284'

1950

1/25

8" @ 805'

4½" @ 3224'

Miss 3212'

Flow 2 MCFGPD

TD 3255'

COMPLETED

Map No. _____ Sec. 2 Twp. 23 R. 3 W

Well No. I Schrag

_____ Geo. Seigrist _____ Company

_____ Contractor

NW SW

**FIRST REPORT
SECTION PLAT**

330 Ft. from N. Line

_____ Ft. from S. Line

_____ Ft. from E. Line

330 Ft. from W. Line

0			

Harvey County

Location _____

Rig up _____

Drilling and Remarks: _____

8" @ 805

RECORD

Cased _____ in., _____ ft.

Sand _____

Gas _____

Oil _____

Total Depth _____

PRODUCTION

1st 24 hrs. Nat. _____

1st 24 hrs. after shot _____

Gas _____ Cu. Ft.

Dry Hole _____

Abandoned _____

Date

DEC 21 1949 19

S. J. LEWIS Scout

Map No. _____ Sec. 2 Twp. 23 R. 3WWell No. 1 Schrag_____
George Seigrist _____ Company_____
Contractor

NW SW

E. 1457
SECTION PLAT

COMPLETE			
o			

330 Ft. from N. Line

_____ Ft. from S. Line

_____ Ft. from E. Line

330 Ft. from W. Line

Harvey County

Location _____

Rig up _____

Drilling and Remarks:

8" @ 8054 1/2" @ 3224miss 3212Flow 2 MCFGPDf

RECORD

Cased _____ in., _____ ft.

Sand _____

Gas _____

Oil _____

Total Depth 3255

PRODUCTION

1st 24 hrs. Nat. _____

1st 24 hrs. after shot _____

Gas _____ Cu. Ft.

Dry Hole _____

Abandoned _____

Date

JAN 25 1950J. E. TYRA19Scout