


Reno

KANSAS

SECTION 2 TOWNSHIP 23S RANGE 4W

WELL NO. #1 White

COMPANY Tomlinson-Kathol

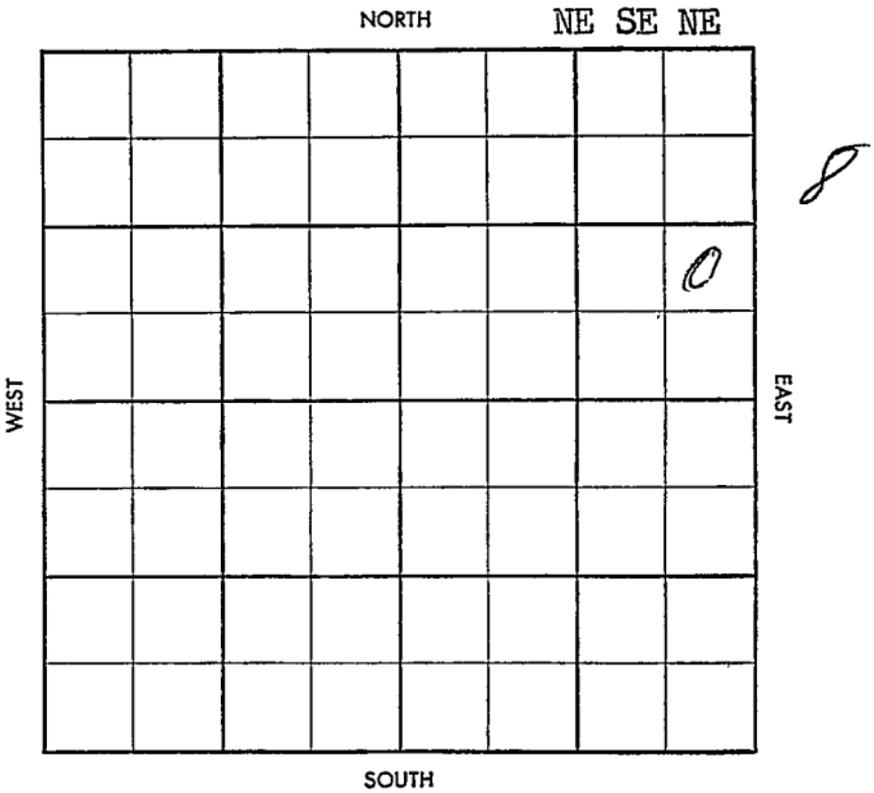

County Reno Elev. _____
 Sec. 2 Twp. 23 Rge. 4W
 Company Tomlinson-Kathol
 Farm Name White No. 1


TOPS	DEPTH	LOG	DATUM
Anh.			
Tp.			
H.			
Tr.			
Dg.			
B.L.			
L.			
K.C.			
B.K.C.			
Ce.			
C.			
M.			
M.			
K.			
Mz.			
Mq.			
V.			
S.			
S.			
A.			
R.			
Pf.			
G.			
T.D.			

Loc. in Sec. _____
NE SE NE
 Geol. _____
 Contr. _____
Co. Tools
 Pool _____
Burrton

FIRST REPORT
 - MAR 5 '58

Date Comm. _____
MIRT

Co.
 Lse.
 No.
 Sec.
 T.
 R.

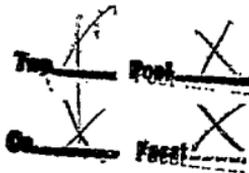

S-513-B

County Reno Elev 1462 DF 1466
 Sec. 2 Twp. (23) Rge. 4W
 Company Tomlinson-Kathol
 Form Name White No. 1

TOPS	DEPTH	LOG	DATUM
Anh.			
Tp.			
H.			
Tr.			
Dg.			
B.L.			
L.			
K.C.			
B.K.C.			
Ce.			
C.			
M.	<u>3251</u>		
M.			
K.			
Mz.			
Ma.			
V.			
S.			
A.			
R.			
Pf.			
G.			
T.D.	<u>3375</u>		

Loc. in Sec. NE SE NE
 Geol. _____
 Contr. _____
 Co. Tools _____
 Pool Burrton



Date Comm. 3-5-58 8" 667
 MIRT " 2 '58 Ø 2170 MAR 18 '58 Ø 3181 MAR 19 '58
 APR 2 '58 APR 12 '58 APR 15 '58 5" 3375 80/3312
-32 APR 23 '58 frac APR 30 '58 P/load
 MAY 7 '58 MAY 14 '58 MAY 21 '58 MAY 28 '58 P25BD
+100 Bwpd
Miss 3312-32

Co. No. L.S. No. Sec. T. R.