


Map No. **KANSAS** Sec. 2 Twp. 23 R. 4^w
 Well No. 3 W hite Farm _____
Study Frost et al Company _____

NORTH

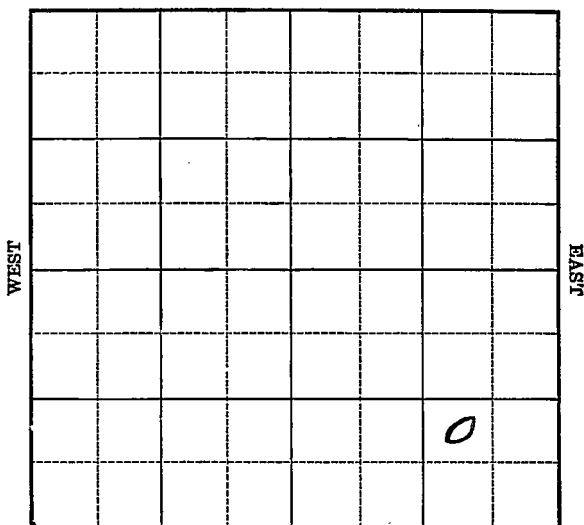

SOUTH

Location _____

Drilling Remarks _____

Rig Up _____

Drilling Remarks _____

RECORD

Cased _____ in. _____ ft.

Sand _____

Gas _____

Oil _____

Total Depth _____

PRODUCTION

1st 24 hrs. Nat. _____

1st 24 hrs. after shot _____

Gas _____ cu. ft. _____

Dry Hole _____

Abandoned _____

Reno


Map No. KANSAS Sec. 2 Twp. 23 R. 4^W
Well No. 3 71 hite Farm _____
Study Frost et al Company _____

_____ Ft. from N. Line

990 Ft. from S. Line

990 Ft. from E. Line

_____ Ft. from W. Line

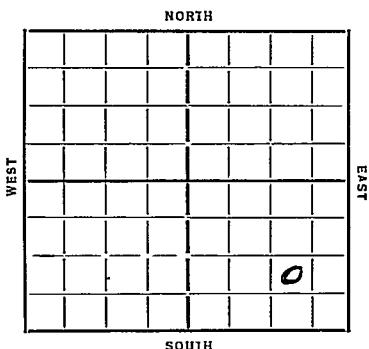

Date 1934

REPORT

9/19 Location
9/26 Rig
10/4 Spud
10/10 TD 173 abd.

ABANDONED

Map No. 40 Sec. 2 Twp. 23 R. 4WWell No. 3-WhiteStudy Throst et al Company

Contractor

SECTION PLAT

			0

Ft. from N. Line

990 Ft. from S. Line990 Ft. from E. Line

Ft. from W. Line

FIRST REPORTS

Location ✓

Rig up

Drilling and Remarks:

RECORD

Cased in., ft.Sand Gas Oil Total Depth

PRODUCTION

1st 24 hrs. Nat. 1st 24 hrs. after shot Gas Cu. Ft.Dry Hole Abandoned

Date

9-19-34 19

ORVAL MANNSCHRECK

Scout

Map No. 40 Sec. 2 Twp. 23 R. 4WWell No. 3-WhiteFrost et al Company

Contractor

SECTION PLAT

ABANDONED

Ft. from N. Line

990 Ft. from S. Line990 Ft. from E. Line

Ft. from W. Line

			0

Location

Rig up

Drilling and Remarks:

RECORD

Cased in., ft.

Sand

Gas

Oil

Total Depth 173

PRODUCTION

1st 24 hrs. Nat.

1st 24 hrs. after shot

Gas Cu. Ft.

Dry Hole

Abandoned

Date

10-10-37 192**ORVAL MANNSCHRECK**
Scout