

KANSAS

Reno


FORM 51 5M 4-41 PETROL

Section 2 Township 23 Range 10-W

Well No. #1 Graber

Company Nate Appleman et al

NORTH Hendrickson Pool

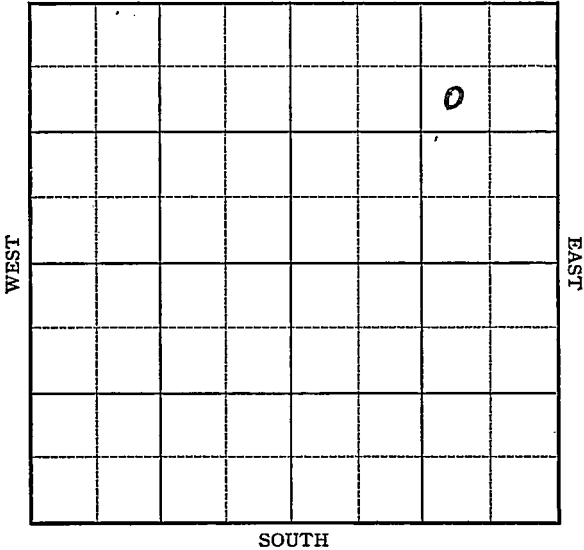

Sec. 2 Twp. 23 R. 10-W

Well No. #1 Graber Farm _____

Nate Appleman et al Company _____

(Hendrickson)


990 Ft. from N. Line

_____ Ft. from S. Line

990 Ft. from E. Line

_____ Ft. from W. Line

Elev. 1745

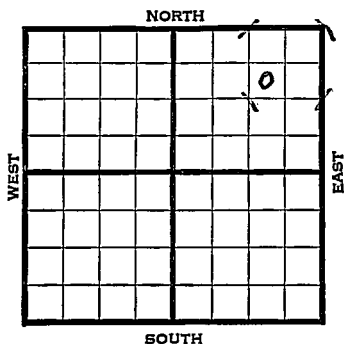

1942	REPORT
5/20	Rotary.
5/27	10" - 245' WOC.
6/3	Drlg. 2810'
6/10	Viola 3691 ³⁶⁸⁹ -97' T.D. Run csg.
6/17	Viola 3687' (Corrected) 5" - 3689'
	T.D. 3689' RUST.
6/24	T.D. 3710' H.F.O. 2000 acid.
7/1	" " "
7/8	" " "
7/15	" " "
7/22	5" @ 3689'
	Viola 3687'
	T.D. 3710'
	2000 acid
	Pump 267 Pot.
	Gravity 42
	COMPLETED

Reno

KANSAS

Map No. 47 Sec. 2 Twp. 23 R. 10W

Well No. 1 Graber

Nate Appleman et al. Company

COMPLETED Contractor

SW NE NE

SECTION PLAT

990 Ft. from N. Line

Ft. from S. Line

990 Ft. from E. Line

Ft. from W. Line

			o

HENDRICKSON POOL

Location _____

Rig up _____

Drilling and Remarks:

Vista 3687
5" @ 3689
2000 acid
Pump 267 Pa
42° Gr

RECORD

Cased _____ in., _____ ft.

Sand _____

Gas _____

Oil _____

Total Depth 2710

PRODUCTION

1st 24 hrs. Nat. _____

1st 24 hrs. after shot _____

Gas _____ Cu. Ft.

Dry Hole _____

Abandoned _____

Date

JUL 22 1942 19

S. J. LEWIS Scout