

KANSAS

Reno


FORM 51 5M 4-41 PETROL

Section 2 Township 23 Range 10-W

Well No. #4 Hinshaw "A"

Company Cities Service Oil

NORTH Hendrickson Pool

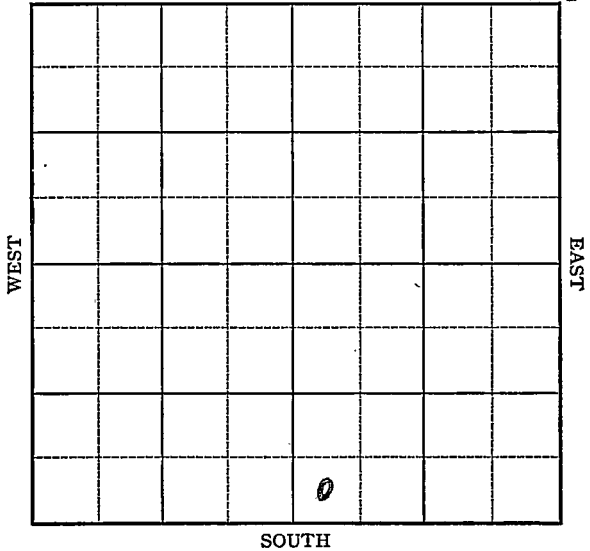

15

SOUTH

Sec. 2 Twp. 23 R. 10-W

Well No. #4 Hinshaw "A" Farm

Cities Service Oil Company

(Hendrickson)


_____ Ft. from N. Line

330 Ft. from S. Line

_____ Ft. from E. Line

330 Ft. from W. Line

Elev. 1762

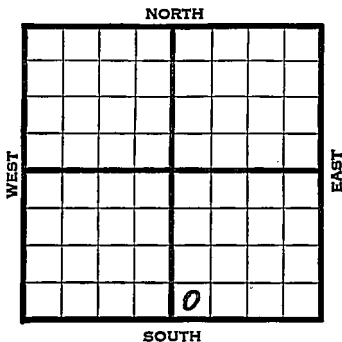

1942

REPORT

5/20 8" - 252' Drlg. 1880'

5/27 Drlg. 3425'

6/3 Lans. 3260' Viola ³⁷⁴⁴~~3757~~-41' T.D.

5" - ~~3741~~³⁷⁴⁸' RUST.

6/10 Viola 3744' 5" - 3748' (Corrected)

T.D. 3761' 1000' oil 1/4 hours.

6/17 Viola 3744'

5" - 3748'

T.D. 3761'

2000 acid.

Bomb potential 1041 bbls.

42. Gravity

COMPLETED

Reno

KANSAS

Map No. 47 Sec. 2 Twp. 23 R. 10W

Well No. 4 Hinshaw "A"

Cities Service Oil Company

FIRST REPORT

Contractor

SW SE

SECTION PLAT

 Ft. from N. Line

330 Ft. from S. Line

 Ft. from E. Line

330 Ft. from W. Line

HENDRICKSON POOL

Location

Rig up

Drilling and Remarks:

8" - 252'

Drlg. 1880'

RECORD

Cased in., ft.

Sand

Gas

Oil

Total Depth

PRODUCTION

1st 24 hrs. Nat.

1st 24 hrs. after shot

Gas Cu. Ft.

Dry Hole

Abandoned

Date

MAY 20 1942 19

S. J. LEWIS Scout

Ren o

Map No. 47 Sec. 2 Twp. 23 R. 10W

Well No. 4 Hinshaw "A"

Cities Service Oil Company

COMPLETED

Contractor

SW SE

SECTION PLAT

_____ Ft. from N. Line

330 Ft. from S. Line

_____ Ft. from E. Line

330 Ft. from W. Line

HENDRICKSON POOL

RECORD

Location _____

Cased _____ in., _____ ft.

Rig up _____

Sand _____

Drilling and Remarks:

Gas _____

Oil _____

Total Depth 376 1/2

Verla 3749 1/2
5" @ 3748
2000 acid
Bon & P 1041

PRODUCTION

1st 24 hrs. Nat. _____

1st 24 hrs. after shot _____

Gas _____ Cu. Ft.

Dry Hole _____

Abandoned _____

42 @ 42

Date

JUN 17 1942 19

S. J. LEWIS Scout