

KANSAS

Reno


FORM 51 5M 10-41 PETROL

Section 2 Township 23 Range 10-W

Well No. #3 Hinshaw "A"

Company Cities Service Oil

NORTH Hendrickson Pool

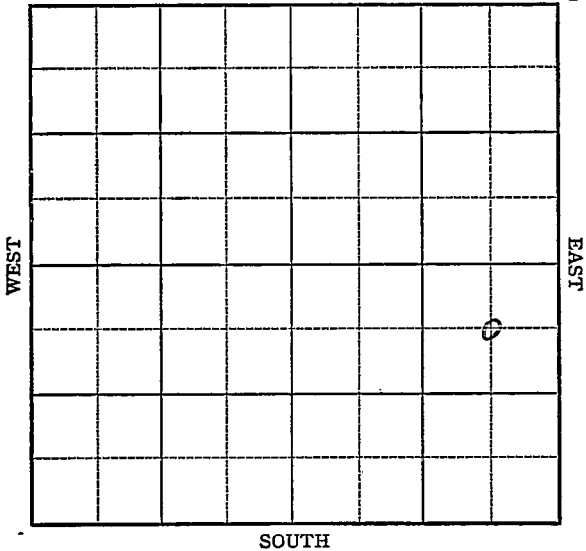

Sec. 2 Twp. 23 R. 10-W

Well No. #3 Hinshaw "A" Farm

Cities Service Oil Company

(Hendrickson)


660 Ft. from N. Line

_____ Ft. from S. Line

660 Ft. from E. Line

_____ Ft. from W. Line

Elev. 1752

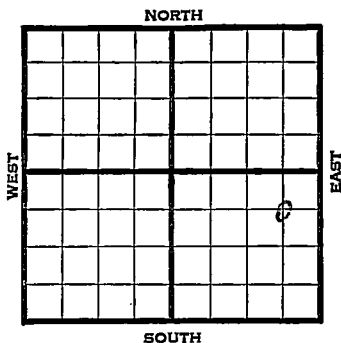

1942

REPORT

4/29 8" - 239' WOC.

5/6 Drlg. 3255'

5/13 Viola ~~3714-16~~³⁷²⁸ T.D. 5" - 3715' RUST.

5/20 Viola 3728' (Corrected) 22' of 4" liner 3730' T.D. 3745' 300' oil 4 hours.

5/27 500 acid. Swab 206 oil plus 15 water 24 hours.

6/3 Viola 3728'

5" - 3715'

4" liner 3730'

T.D. 3745'

500 acid.

Pump 206 oil & 15 water.

42. Gravity

COMPLETED

KANSAS

Reno

Map No. 47 Sec. 2 Twp. 23 R. 10WWell No. 3 Hinshaw "A"Cities Service Oil Company*FIRST REPORT Contractor

C NE SE

SECTION PLAT

660 Ft. from N. Line Ft. from S. Line660 Ft. from E. Line Ft. from W. Line

			o

HENDRICKSON POOLLocation Rig up

Drilling and Remarks:

8" - 239'Waiting on
cement to set

RECORD

Cased in., ft.Sand Gas Oil Total Depth

PRODUCTION

1st. 24 hrs. Nat. 1st 24 hrs. after shot Gas Cu. Ft.Dry Hole Abandoned

Date

APR 29 1942 19S. J. LEWIS Scout

Reno

Map No. 47 Sec. 2 Twp. 23 R. 10W

Well No. 3 Hinshaw "A"

Cities Service Oil Company

COMPLETED Contractor

SECTION PLAT

C NE SE

660 Ft. from N. Line

_____ Ft. from S. Line

660 Ft. from E. Line

_____ Ft. from W. Line

			o

HENDRICKSON POOL

Location _____

Rig up _____

Drilling and Remarks:

Viola 3728

5" 3715

4" lined 3730

500 acid

Pump 206 oil + 15 Water

42 9/16

RECORD

Cased _____ in., _____ ft.

Sand _____

Gas _____

Oil _____

Total Depth 8745

PRODUCTION

1st 24 hrs. Nat. _____

1st 24 hrs. after shot _____

Gas 15 Cu. Ft.

Dry Hole _____

Abandoned _____

Date

JUN 3 1942 19

S. J. LEWIS Scout