


Section 2 Township 23 Range 10W

Well No. 3 Phillips

Company Lion Oil

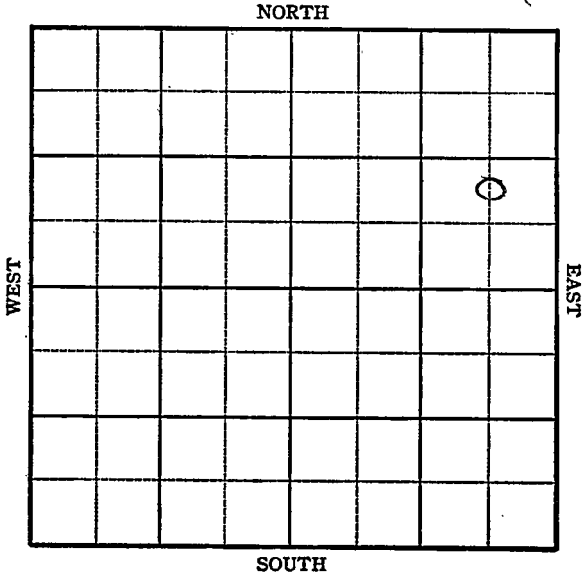

KANSAS

Sec. 2 Twp. 23 R. 10W

Well No. #3 Phillips Farm

Lion Oil Company

Peace Creek


_____ Ft. from N. Line

990 _____ Ft. from S. Line

660 _____ Ft. from E. Line

_____ Ft. from W. Line

CNL SE NE

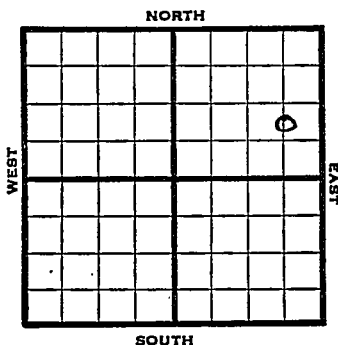

1945 REPORT
Elev. 1752

10/31 Derrick
11/7 Drlg. 1680'
11/14 Drlg. 3585'
11/21 Viola 3700
TD 3716
5" @ 3702
1500' oil 2 hrs.
11/28 Flow 12 oil per hr.
12/5 " " " "
12/12 " " " "
12/20 " " " "
12/29 " " " "

1946

1/9 Viola 3700
5" @ 3702
500 acid.
TD 3716
Pump 203 Pot.
Grav. 42.0

COMPLETED

KANSAS Pool Name Peace Creek
 Kansas
 Map No. 47 Sec. 2 Twp. 23 R. 10W
 Well No. 3 Phillips

Lion Oil Company

COMPLETED Contractor
C N L SE NE E. I. 1952

SECTION PLAT

			0

 Ft. from N. Line

990 Ft. from S. Line

660 Ft. from E. Line

 Ft. from W. Line

~~Reno County~~

Location

Rig up

Drilling and Remarks:

Viola 8700

5" C 8702

500 acid

Pump 203 Pd

42 0/4

RECORD

Cased in., ft.

Sand

Gas

Oil

Total Depth 0716

PRODUCTION

1st 24 hrs. Nat.

1st 24 hrs. after shot

Gas Cu. Ft.

Dry Hole

Abandoned

Date

JAN 9 1946 19 S. I. LEWIS Scout