


Section 2 Township 23 Range 11WWell No. 1 ParksCompany Champlin Ref.

NORTH

WEST

EAST

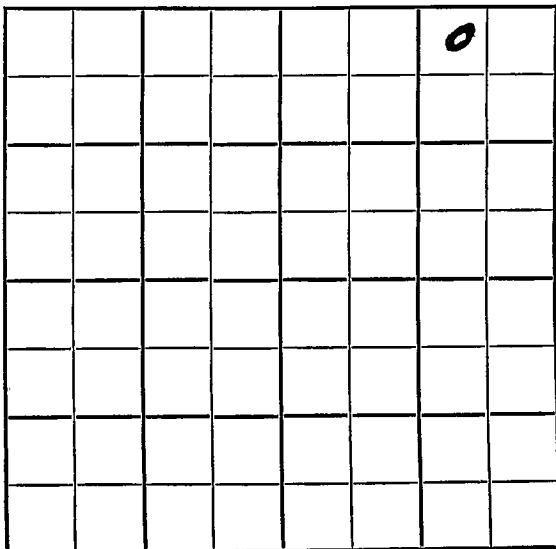

SOUTH

# Stafford KANSAS

SEC. 2 TWP. 23 R. 14W

WELL NO.

1 Parks

FARM

COMPANY

Champlin Ref.

CONTRACTOR

Garvey-

Wildcat


330 Ft. from N. Line

Ft. from S. Line

990 Ft. from E. Line

Ft. from W. Line

NW NE NE

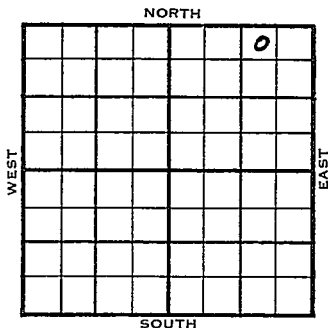

Texas & Gulf-DHM

| 1954 | ELEVATION | REPORT |
|------|-----------|--------|
| 1941 |           |        |

7/7 Spudding 6-28-54  
8" @ 228  
Anhy 855 Heeb. 3358 Lans. 3504  
Drfg. 3642  
DST 3616-34 opeb 1 hr. Rdc. 15' vsocm  
180#

7/14 Spud 6-28-54 - D&A  
TD 3977'  
8" @ 228'  
Anhy 855', Heeb 3358', Lans 3504'  
DST 3616-34, opn 1 hr., rec. 15' vsocm  
180#  
B KC 3725',  
DST 3660-72, opn 1 hr., rec. 105' sw,  
1130#  
Viola 3794'  
DST 3790-3806', opn 1 hr., rec. 15'  
mud, off  
Simp. 3826 3862', Arb. 3907'  
TD 3977'  
D&A

ABANDONED

County **Stafford** State **Kansas**  
 Sec. **2** (Blk. Twp.) **23** (Sur. Rge.) **14W** Map No.  
 Operator **Champlin Ref.**  
 Well No. **1** Farm **Parks**  
 Elev. **1941** Location **NW NE NE**

|  |  |  |  |  |  |  |  |  |  |
|--|--|--|--|--|--|--|--|--|--|
|  |  |  |  |  |  |  |  |  |  |
|  |  |  |  |  |  |  |  |  |  |
**FIRST REPORT**

**330** Ft. From **N** Line **NE**  
**990** Ft. From **E** Line **Quarter**

Ist. Report **JUL 7 1954**

Completion

Remarks **Texas & Gulf - IHM**

**Garvey - Contr.**

Spudding Date **6-28-54**

Drlg. Data


**Wildcat**

**8" @ 228 Any 855 Heeb. 3358**

**Lans. 3504 drlg. 3642 DST 3616-34**

**open 1/hr. Rec. 15' vsocm 180#**

**J. G. McGEHEE**

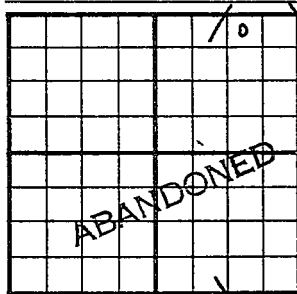County Stafford State KansasSec. 2 (Blk.) 23 (Sur.) 14W Map No.Operator Champlin Ref.Well No. 1 Farm ParksElev. 1941 Location NW NE NE330. Ft. From N Line NE990. Ft. From E Line Quarter

1st. Report

Completion JUL 14 1954Remarks WildcatGarvey - Contr.Spudding Date 6-28-54Drlg. Data D & A TD 39778" @ 228 Anhy 855 Heeb. 3358Lans. 3504 DST 3616-34 open 1 hr.Rec. 15' vsocm 180# B KC 3725DST 3660-72 open 1 hr. Rec. 105' sw1130# Viola 3794 DST 3790-3806open 1 hr. Rec. 15' mud 0#Simp. 3862 Arb. 3907 TD 3977D & A

J. G. McGEHEE