


SECTION 2 TOWNSHIP 23 RANGE 17 ^W

WELL NO. #5 Boyd

COMPANY Colorado O & G

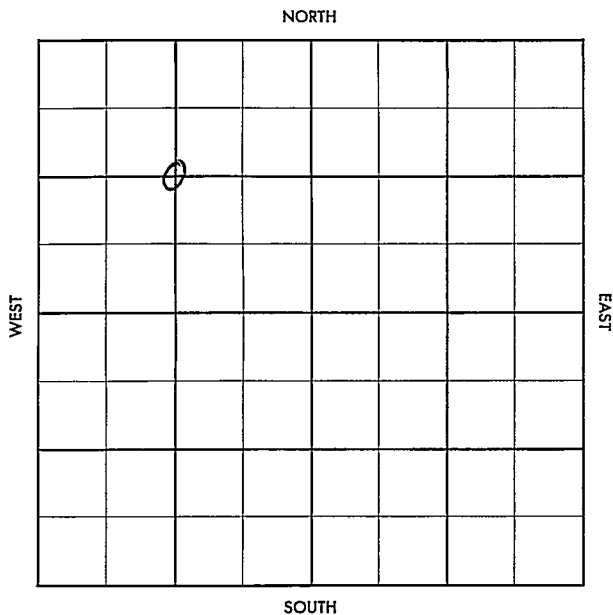

Pawnee

KANSAS

SEC.	TWP.	R.
2	23	17W

WELL NO.

#5 Boyd

FARM

COMPANY

Colorado O&G

CONTRACTOR

Honaker


Garfield

Ft. from N. Line

Ft. from S. Line

Ft. from E. Line

Ft. from W. Line

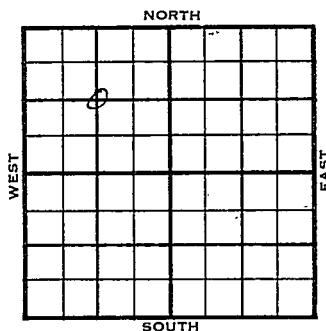C NW $\frac{1}{4}$ 

	ELEVATION	REPORT
1955	2084	
11-23	Comm. 11-12-55 8" @ 254/175 Drlg. 4135	
12-28	5 $\frac{1}{2}$ " @ 4277/175 CO 32/ 4194-4202 B/ 3 gm, 500 A F/ 15.03 bo 1 hr., 13,04 boph, 4 hrs. Comp.. F/ 326 bopd BL. 3735 L. 3743 Sh. 4148 Cong. ch. 4171 V. 4271 TD 4278'	
COMPLETED		

County Pawnee Elev. 2081
 Sec. 2 Twp. 23 Rge. 17W
 Company Colorado O & G
 FarmName Boyd No. 5

Co.

Lse.

T. No.

Sec.

T.

R.

TOPS	DEPTH	LOG	DATUM
Anh.			
Tr.			
H.			
Tr.			
Dg.			
Bl.			
L.			
K.C.			
B.K.C.			
Ce.			
C.			
M.			
M.			
K.			
Mz.			
Mo.			
V.			
S.			
S.			
A.			
R.			
P.			
G.			
T.D.			

Loc. in Sec.

C NW/4

Geol.

Contr.

Honaker

Popl.

Garfield



FIRST REPORT

NOV 23 '55

Date Comm. 11-12-55
8" @ 254/175 drlg. 4135

[Handwritten signature]

County Pawnee Elev. 2084 Co. Co.
 Sec. 2 Twp. 23 Rge. 17W
 Company Colorado O & G
 Farm Name Boyd No. 5

TOPS	DEPTH	LOG	DATUM	Loc. in Sec.
Anh.				C NW/4
Tr.				
H.				
Tr.				
Dg.				
Bl.	3735		1651	
L.	3743		1659	Geol.
K.C.				
B.K.C.				Contr.
Ce.				
C. <i>Ch.</i>	4148		2064	Honaker
M. <i>Comp. Ch.</i>	4171		2087	Pool
M.				Garfield
K.				
Mz.				
Ma.				
V.	4271		2187	
S.				
S.				
A.				
R.				
Pe.				
G.				
T.D.	4278			

Date Comm. 11-12-55 DEC 28 1955

8" @ 254/175 5 $\frac{1}{2}$ " @ 4277/175

CO 32/ 4194-4202 B/ 3 gm 500 A

F/ 15.03 bo 1 hr. 13.04 boph 4 hr.

Comp. F/ 326 bopd

COMPLETE