


PX 78-1 Pawnee

KANSAS

Section 2 Township 23 Range 17W

Well No. #4 Hines

Company Hilton Drlg

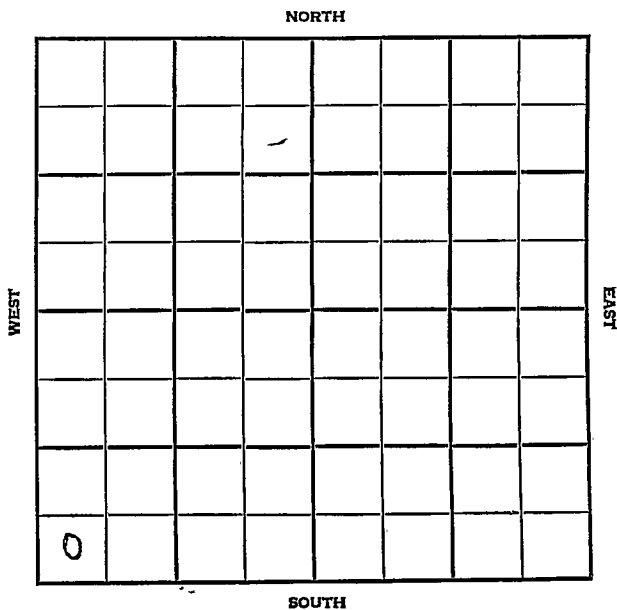

Pawnee


KANSAS

SEC. 2	TWP. 23	R. 17W
-----------	------------	-----------

WELL NO. #4 Hines FARM  
COMPANY

CONTRACTOR Hilton Drlg.  
Co. Tools

Garfield  
\_\_\_\_\_ Ft. from N. Line  
\_\_\_\_\_ Ft. from S. Line  
\_\_\_\_\_ Ft. from E. Line  
\_\_\_\_\_ Ft. from W. Line

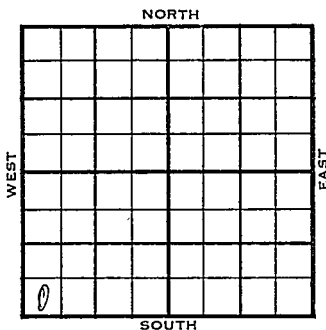

~~#####~~ SW SW SW

1956	ELEVATION 2090	REPORT
------	-------------------	--------

3-21 Comm. 3-13-56  
8" @ 215/200  
Brlg. 2810

4-4 DST 4181-94 op 1 hr. rec. 30' mud,  
80/20"  
DST 4202-60 op 1 hr. rec. 30' mud,  
100/30"  
D & A  
H. 3622  
BL 3741  
L. 3748  
C. Shly 4159  
Cg Chart 4184  
TD 4290

**ABANDONED**

County Paynee Elev. \_\_\_\_\_  
 Sec. 2 Twp. 23 Rge. 17W  
 Company Hilton Drlg.  
 FarmName Hines No. 4

TOPS	DEPTH	LOG	DATUM	Loc. in Sec.
Anh.				SW SW SW
Tp.				
H.				
Tr.				
Dg.				
Bl.				
L.				
K.C.				Geol.
B.K.C.				Contr.
Ce.				Co. tools
C.				
M.				Pool
M.				Garfield
K.				
Mz.				
Mq.				
V.				
S.				
S.				
A.				FIRST REPORT
R.				MAR 21 '56
PE.				
G.				
T.D.				0

Date Comm. 3-13-56  
8" @ 215/200 drlg. 2810

\_\_\_\_\_  
 \_\_\_\_\_  
 \_\_\_\_\_  
 \_\_\_\_\_  
 \_\_\_\_\_  
 \_\_\_\_\_  
 \_\_\_\_\_  
 \_\_\_\_\_

Co.  
Lse.  
No.  
Sec.  
T.  
R.

County Pawnee Elev. 2090  
 Sec. 2 Twp. 23 Rgs. 17W  
 Company Hilton Drlg.  
 FarmName Hines No. 4

Co.

TOPS	DEPTH	LOG	DATUM
Anh.			
TP.			
H.	<u>3622</u>		
Tr.			
Dg.			
BL.	<u>3741</u>		<u>No 51</u>
L.	<u>3748</u>		<u>1858</u>
K.C.			
B.K.C.			
Ce.			
C. <u>shly</u>	<u>4159</u>		<u>2069</u>
M. <u>Cg / Chest</u>	<u>4184</u>		<u>2094</u>
M.			
K.			
Mz.			
Me.			
V.			
S.			
S.			
A.			
R.			
PE.			
G.			
TD.	<u>4290</u>		

Loc. in Sec. SW SW SW  
 Geol. \_\_\_\_\_  
 Contr. \_\_\_\_\_  
 Co. tools \_\_\_\_\_  
 Pool \_\_\_\_\_  
Garfield  
**ABANDONED**  
 APR 4 '56

Loc.

No.

Sec.

T.

R.

Date Comm. 3-13-56  
8" @ 215/200 DST 4181-94 open 1 hr.  
rec. 30' mud 80/20" DST 4202-60  
open 1 hr. rec. 30' mud 100/30"

D & A