


Finney

KANSAS

Section 2 Township 23 Range 33W

Well No. #1 M. R. Pearce

Company Northern Pump

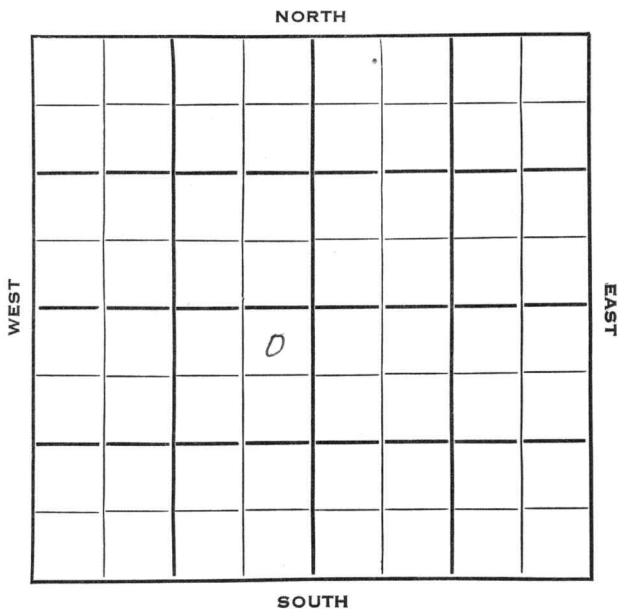

Finney

KANSAS

Sec. 2 Twp. 23 R. 33 WWell No. # 1 M. R. Pearce FarmNorthern Pump Company

Contractor


200 Ft. from N. Line

Ft. from S. Line

200 Ft. from E. Line

Ft. from W. Line

NE SW

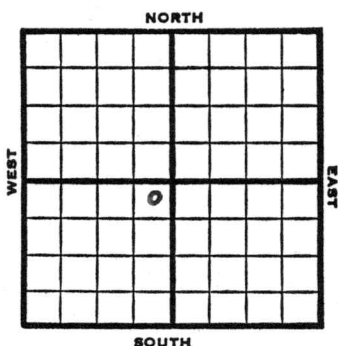

1953

Elev. 2876' REPORT

3/25

Location

4/2

10" @ 335

Drlg 1360

4/9

Drlg. 2495'

4/16

Her 2519, Kr. 2548, Win 2578,
RTD 2585

7" @ 2580'

6/ 2544- sq. 6/ 2574 sq.

4/23

Testing

4/29

Spud 3-27-53 Gas well TD 2589'

10" @ 335 Her 2519' Kri 2548'

Win 2578 TD 2585' 7" @ 2580

6/2544 6/2574 DD 2589'

3,214,000 gas Dol-frac 1500 A

7,500,000 gas PB 2570

56/2552-66 24/2528-34 Dol-frac.

Comp. 17,603,000 gas 423#

COMPLETED

County **Finney** State **Kansas**
 Sec. **2** (Blk.) **23** (Sur.) **33W** Map No.
 Operator **Northern Pump**
 Well No. **1** Farm **M. R. Pearce**
 Elev. Location **NE SW**

FIRST REPORT

200 Ft. From **N** Line **SW**
 200 Ft. From **E** Line Quarter
 1st. Report **MAR 25 1953**
 Completion
 Remarks
 Spudding Date

Drlg. Data

Location

