

Section 2 Township 23 Range 34W

Well No. #1 W. H. Splitter

Company Northern Pump

NORTH

				C			

WEST

EAST

SOUTH

Sec. 2 Twp. 23 R. 34W ✓Well No. #1 W. H. Splitter FarmNorthern Pump CompanyHugoton Pool Contractor


Ft. from N. Line

150 Ft. from S. Line

Ft. from E. Line

150 Ft. from W. Line

SW NE

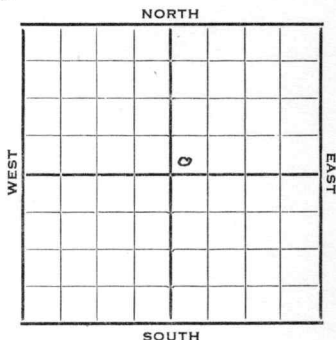

1952

Elev. 2936' REPORT

7/30

Location

8/6

10" @ 367

8/13

Hol 2500 Her 2526
RTD 2533 7" @ 2526'

8/20

NR

8/27

Drlg. 2580'

9/3

Winfield 2580 DD 2612 TD
24,000 A

9/10

109' of 5" liner 2500 A

9/17

NR

9/24

"

10/1

Spud 8-1-52

Gas Well TD 2612'

10" @ 367 7" @ 2526

TD 2533' Hol. 2500 Her. 2526

Win. 2580 DD 2612' 24000 A

Comp. 7,200,000 gas 382#

COMPLETED

County **Finney** State **Kansas**

Sec. **2** (Blk. Twp.) **23** (Sur. Rge.) **34W** Map No.

Operator **Northern Pump**

Well No. **1** Farm **W. H. Splitter**

Elev.	Location	SW NE
-------	----------	--------------

150 Ft. From S Line NE

150 Ft. From W Line Quarter

1st. Report JUL 3 0 1952

Completion

Remarks


Spudding Date _____

Drlg. Data Hugot on Pool

Location

J. G. McGEHEE

County Finney State Kansas
 Sec. 2 (Blk.) 23 (Sur.) 34W Map No. (Twp.)
 Operator Northern Pump
 Well No. 1 Farm W. H. Splitter
 Elev. 2936 Location SW NE

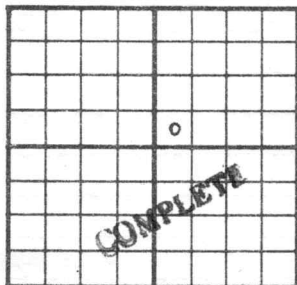

150 Ft. From S Line NE
150 Ft. From W Line Quarter

1st. Report

Completion OCT 1 1952

Remarks Hugoton Pool

Spudding Date 8-1-52

Drlg. Data Gas well TD 2612

10" @ 367 7" @ 2526 TD 2533

Hol. 2500 Her. 2526 Win. 2580

DD 2612 24000 A

Comp. 7,200,000 gas 382#

J. G. McGEE