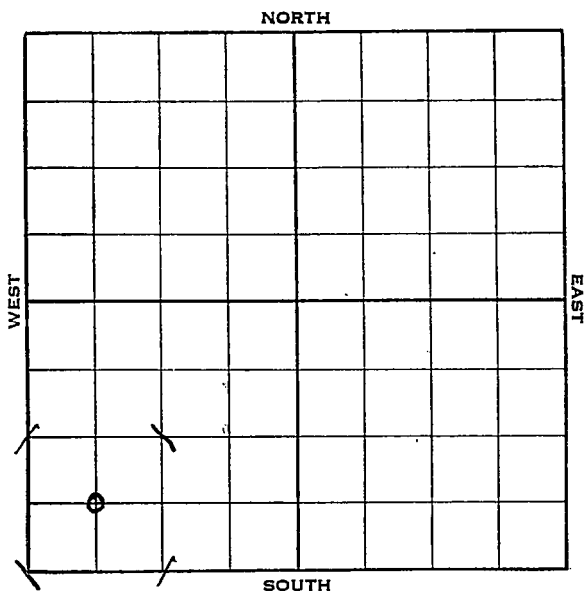


Harvey


Section 20 Township 23 Range 3-WWell No. 1 Dole et alCompany E. J. Shaffer

KANSAS

Harvey

Sec. 20 Twp. 23 R. 3-WWell No. #1 Dole et al FarmE. J. Shaffer Company Ft. from N. Line660 Ft. from S. Line Ft. from E. Line660 Ft. from W. Line

Elev. 1456

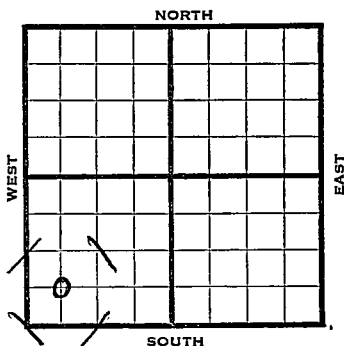

1938	REPORT
5/4	Cellar.
5/12	"
5/20	"
5/27	"
6/3	R. R.
6/10	13" @ 243'. WOC.
6/17	Dr lg. 2610'.
6/24	Chat 3260'. T. D. 3430'.
	7" - 3422'. RUST.
7/1	Perf. 10 shots 3355-56'
	30 shots. 3357-60'
	2300' oil
7/8	" " "
7/13	7" - 3422'.
	Chat 3260'.
	T. D. 3430'.
	Perf. 40 shots.
	Potential 70 bbls. oil.
	Made 11 bbls. water per hour on
	potential test.

COMPLETED

Harvey KANSAS

Map No. 39 Sec. 20 Twp. 23 R. 3WWell No. 1 Dole etalE. J. Shaffer Company


Contractor

FIRST REPORT

C SW SW

 Ft. from N. Line660 Ft. from S. Line Ft. from E. Line660 Ft. from W. Line

SECTION PLAT

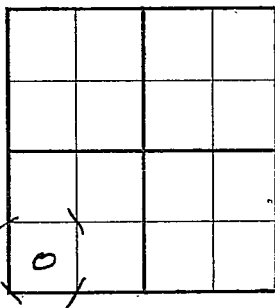Location Rig up Drilling and Remarks:
Cellar

RECORD

Cased in., ft.Sand Gas Oil Total Depth

PRODUCTION

1st 24 hrs. Nat. 1st 24 hrs. after shot Gas Cu. Ft.Dry Hole Abandoned

Date

MAY 4 - 1938 19 H. D. Hatfield Scout

Harvey KANSAS

Map No. 39 Sec. 20 Twp. 23 R. 3WWell No. 1 Dole et alE. J. Shaffer Company

Contractor

COMPLETED

C SW SW

 Ft. from N. Line660 Ft. from S. Line Ft. from E. Line660 Ft. from W. Line

SECTION PLAT

0			

Location Rig up

Drilling and Remarks:

*Perf - 40 shots**POT 70 oil**made 11 bbls wt. P. 4
on POT. Test*

RECORD

Cased 7 in. 3422 ft.Sand Chat 3260Gas Oil Total Depth 3430

PRODUCTION

1st 24 hrs. Nat. 1st 24 hrs. after shot Gas Cu. Ft.Dry Hole Abandoned

Date

JUL 13 1938H. D. Hatfield Scout