

KANSAS

Form 51—5M—11-38—Palace


Harvey

Section 20 Township 23 Range 3-W

Well No. #2 Wilson

Company E. H. Shaffer

NORTH Burrton Pool

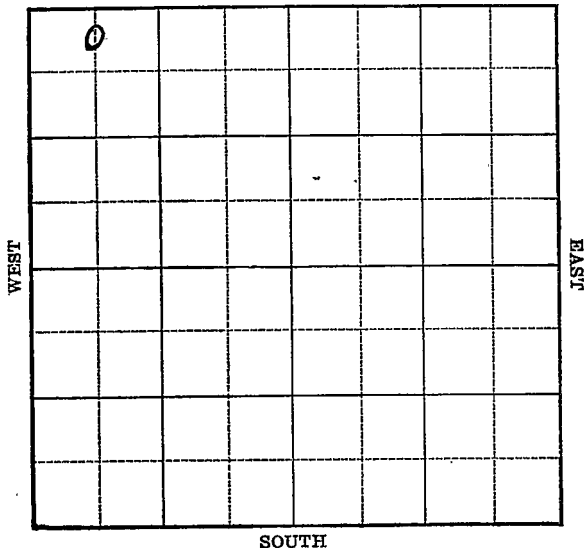

Harvey

KANSAS

Map No. 39 Sec. 20 Twp. 23 R. 3WWell No. 2 WilsonE. J. Shaffer Company

Contractor

FIRST REPORT

6 N L NW NW330 Ft. from N. Line Ft. from S. Line Ft. from E. Line660 Ft. from W. Line

BURRTON POOL

SECTION PLAT

0			

Location Rig up

Drilling and Remarks:

Rotary

RECORD

Cased in., ft.Sand Gas Oil Total Depth

PRODUCTION

1st 24 hrs. Nat. 1st 24 hrs. after shot Gas Cu. Ft.Dry Hole Abandoned

Date

19

S. J. LEWIS Scout

Harvey

KANSAS

Map No. 39 Sec. 20 Twp. 23 R. 3WWell No. 2 WilsonE. J. Shaffer

Company

Contractor

COMPLETED

C N L NW NW

330 Ft. from N. Line Ft. from S. Line Ft. from E. Line660 Ft. from W. Line

BURRTON POOL

SECTION PLAT

0			

Location Rig up

Drilling and Remarks: *

*Chk 3252**7" C 3282.**4000 acal**Pay Hole Born**Pay 688*

RECORD

Cased in., ft.Sand Gas Oil Total Depth 3360

PRODUCTION

1st 24 hrs. Nat. 1st 24 hrs. after shot Gas Cu. Ft.Dry Hole Abandoned

Date

JAN 3 1939

S. J. LEWIS Scout