

DX 78-1


Stafford

KANSAS

Section 20 Township 23 Range 13W

Well No. #2
~~#1~~ Schulz

Company D. R. Lauck

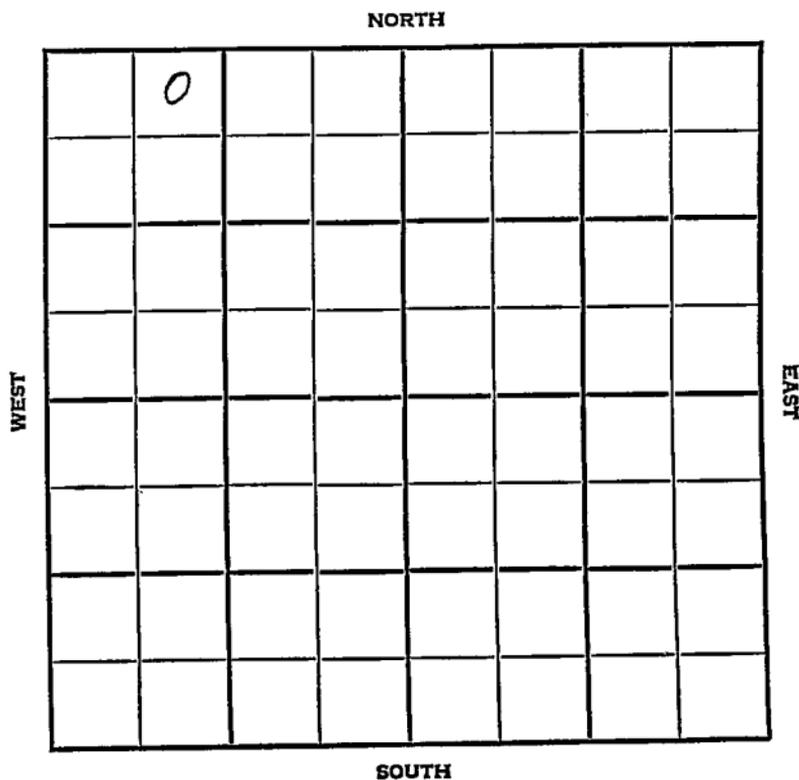

Stafford

KANSAS


SEC.	TWP.	R.
20	23	13W

WELL NO. #2
 1 Schulz FARM

COMPANY
 D. R. Lauck

CONTRACTOR
 Co. Tools
 NW St. John Pool

330' _____ Ft. from N. Line
 _____ Ft. from S. Line
 _____ Ft. from E. Line
 990' _____ Ft. from W. Line

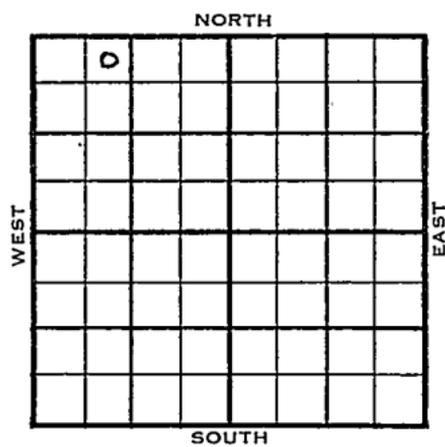

NE NW NW

1955	ELEVATION	REPORT
	1915	

6/1
 10/5

M I R
 Comm 5-31-55
 8 5/8" @ 227
 H 3356
 BL 3497
 L 3508
 BKC 3761
 C 3842
 V 3854
 S 3905
 A 3956
 TD 3958
 lost hole skid 15' East spud 6-9-55
 8 5/8" @ 168 DST 3633-47 open 1 hr
 Rec 110' hoc froggy & geo 825#
 DST 3666-88 open 35 min. Rec 30' mud
 Off 5 1/2" @ 3956 DD 3962 2 1/2 to 3
 boph 500 A 20 boph Comp 40 bopd
 14% wtr.

COMPLETED

SCOUT TICKET

DX-201

Kansas

SEC.	TWP.	R.
20	23	13W

WELL NO. _____

2 Schulz FARM

COMPANY _____

D. R. Lauck

CONTRACTOR _____

CORRECTION


NE NW NW

330 FT. FROM N. LINE

_____ FT. FROM S. LINE

_____ FT. FORM E. LINE

990 FT. FROM W. LINE

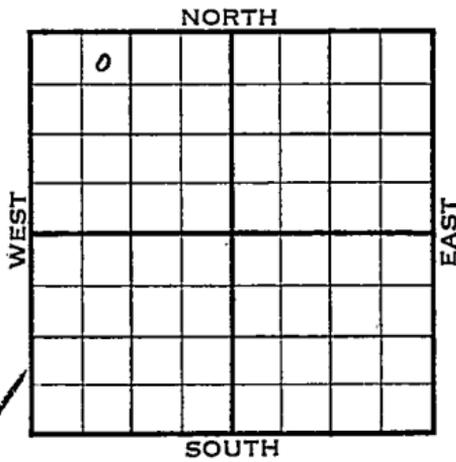

Stafford County

LOCATION

RIG UP

DRILLING AND REMARKS:

Reported
#1 Schulz

RECORD	CASED IN.. FT.
	SAND
	GAS
	OIL
PRODUCTION	TOTAL DEPTH
	1ST 24 HRS. NAT.
	1ST 24 HRS. AFTER SHOT
	GAS CU. FT.
	ABANDONED

DATE JUN 15 1955

SCOUT *L. D. Harris*

County Stafford Elev. 1915Sec. 20 Twp. 23 Rge. 13WCompany D. R. LauckFarmName Schulz No. 2

Co.

Lse.

No.

Sec.

T.

R.

TOPS

DEPTH

LOG

DATUM

Loc. in Sec.

Anh.

T.p.

H.

Tr.

Dg.

BL.

L.

K.C.

B.K.C.

Ce.

C.

M.

M.

K.

Mz.

Mq.

V.

S.

S.

A.

R.

P.E.

G.

T.D.

NE NW NW

Geol.

Contr.

Co. tools

Pool

NW St. John

COMPLETE

Date Comm. 5-31-55 OCT 5 19558 5/8" @ 227 lost hole skid 15' Eastspud 6-9-55 8 5/8" @ 168 DST 3633-47open 1 hhr. Rec. 110' hoc froggy & geo825# DST 3 666-88 open 35 min. Rec.30' mud 0# 5 1/2" @ 3956 DD 39622 1/2 to 3 boph 500 A 20 bophComp. 110 bopd 14% wtr.