

Stafford


KANSAS

SECTION 20 TOWNSHIP 23 RANGE 13 W

WELL NO. #3 Schulz

COMPANY D.R. Lauck

NORTH

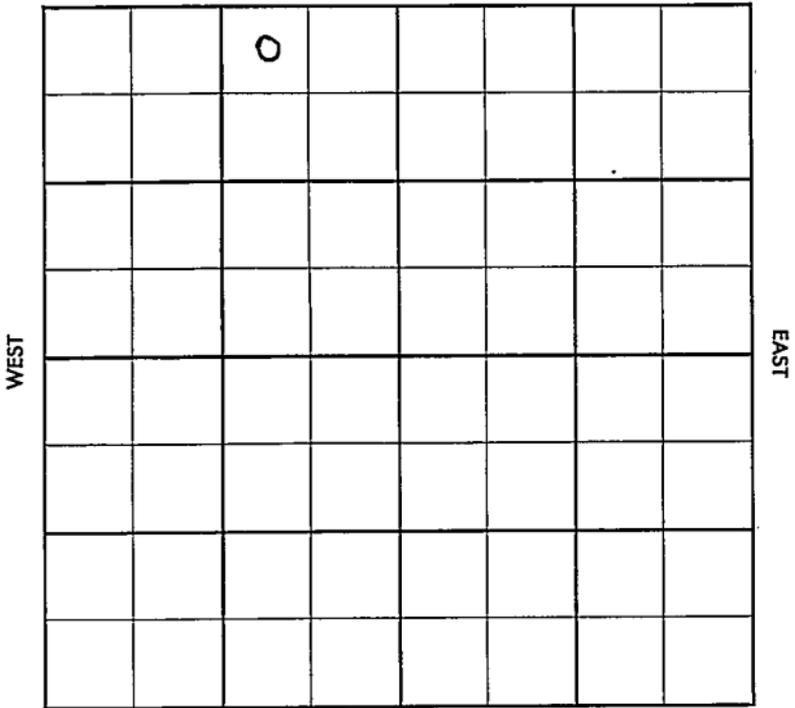

SOUTH



County Stafford Elev. \_\_\_\_\_  
 Sec. 20 Twp. 23 Rgs. 13W  
 Company D. R. Lauck  
 Farm Name Schulz No. 3

TOPS	DEPTH	LOG	DATUM
Anh.			
Tp.			
H.			
Tr.			
Dg.			
Bl.			
L.			
K.C.			
B.K.C.			
Ce.			
C.			
M.			
M.			
K.			
Mz.			
Mq.			
V.			
S.			
S.			
A.			
R.			
PE.			
G.			
T.D.			

Loc. in Sec. NW NE NW  
900' EL  
 Geol. \_\_\_\_\_  
 Contr. \_\_\_\_\_  
Co. tools  
 Pool \_\_\_\_\_  
NW St. John


FIRST REPORT  
 OCT 26-55

Date Comm. 10-20-55  
8" @ 157/150 drlg. 2480

*Handwritten mark resembling a stylized 'S' or '3' with a diagonal slash through it.*

Co. \_\_\_\_\_  
 Lse. \_\_\_\_\_  
 No. \_\_\_\_\_  
 Sec. \_\_\_\_\_  
 T. \_\_\_\_\_  
 R. \_\_\_\_\_

County Stafford Elev. 1912  
 Sec. 20 Twp. 23 Rge. 13W  
 Company D. R. Lauck  
 Farm Name Schulz No. 3

TOPS	DEPTH	LOG	DATUM
Anh.			
Tr.			
H.	3359	3356	1444
Tr.			
Dg.			
Bl.	3497	3495	1583
L.	3509	3508	1596
K.C. Drum		3642	1750
B.K.C.	3765	3779	1867
Ce.			
C.			
M.			
M.			
K.			
Mz.			
Ma.			
V.		3864	1952
S. sh		3900	1988
S.			
A		3955	2043
R.			
Pe.			
G.			
T.D.	3957		

Loc. in Sec. NW NE NW  
900' EL

Geol. \_\_\_\_\_  
 Contr. \_\_\_\_\_  
 Co. tools \_\_\_\_\_  
 Pool NW St. John

	0		
COMPLETE			

Date Comm. 10-20-55 DEC 21 1955  
8" @ 157/150 DST 3630-48 open 1 hr.

rec. 2570' gas 90' o & gcm 35' ho & gcm  
330/20" DST 3669-90 open 1/2 hr.  
rec. 10' mud 310/20" 5 1/2" @ 3956  
CO PB 3911 45/ 3638-44 2500 A  
S/ 5 boph 8 hr. Comp. 49 bopd

Co.  
Lse.  
No.  
Sec.  
T.  
R.