


Section 20 Township 23 Range 13 W

Well No. # 1 Schultz "B" (*Shultz*)

Company C R A

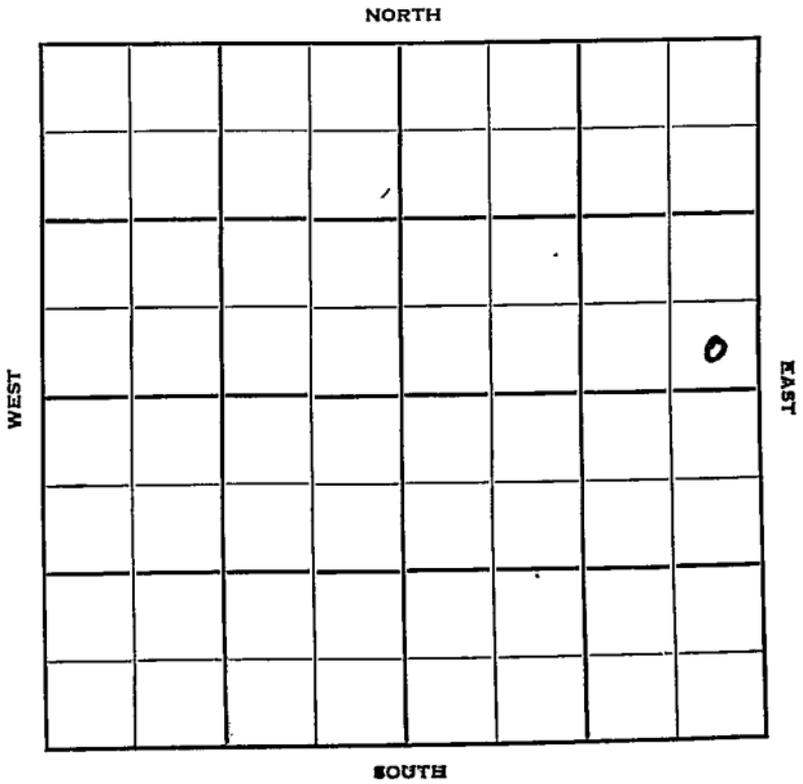

Stafford

KANSAS ✓


Sec. 20 Twp. 23 R. 13W

Well No. #1 Schultz "B" Farm _____

C R A Company _____

Contractor _____

_____ Ft. from N. Line
330 Ft. from S. Line
330 Ft. from E. Line
 _____ Ft. from W. Line
SE SE NE

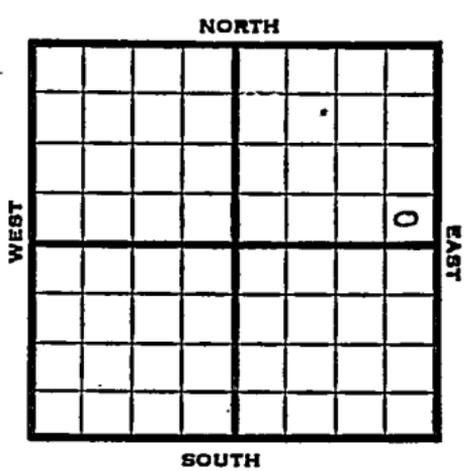

1952 Elev. 1885' REPORT

10/8 Location
 10/15 "
 10/22 "
 10/29 Spud 10-17-52
 D&A TD 3680'
 8" @ 317'
 Heeb. 3324 Doug. 3359
 Br Li 3463 Lans. 3488
 TD 3680
 DST 3603-21 open 1 hr. rec. 3' mud Off
 DST 3650-80 open 1 hr. rec. 10' mud
 & SSO Off D&A

ABANDONED


County Stafford State Kansas

Sec. 20 (Blk. Twp.) 23 (Sur. Rge.) 13W Map No.

Operator C R A

Well No. 1 Farm Schultz "B"

Elev. _____ Location SE SE NE

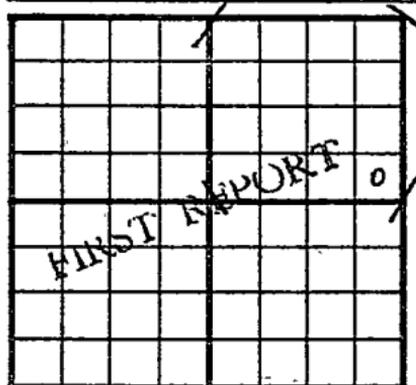

350 Ft. From S Line NE

350 Ft. From E Line Quarter

1st. Report OCT 8 1952

Completion _____

Remarks _____

Spudding Date _____

Drilg. Data _____

Location


County Stafford State Kansas

Sec. 20 (Blk. 23 (Sur. 13W Map No. Twp. Rge.)

Operator C R A

Well No. 1 Farm Schultz "B"

Elev. 1885 Location SE SE NE

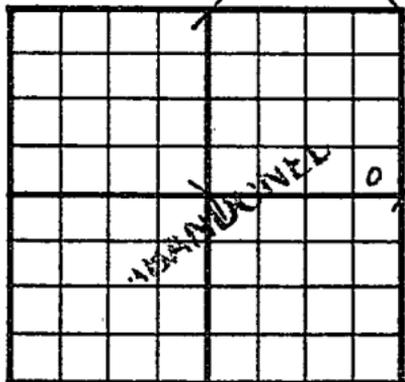

330 Ft. From S Line NE

330 Ft. From E Line Quarter

1st. Report

Completion OCT 29 1952

Remarks

Lewis Drlg. - Contr.

Spudding Date 10-17-52

Drlg. Data D & A TD 3680

8" @ 317 Heeb. 3324 Doug. 3359

Br. lime 3463 Lans. 3488 TD 3680

DST 3603-21 open 1 hr. Rec. 3' mud

0# DST 3650-80 open 1 hr. Rec. 10' mud

& SSO 0#

D & A