

Stafford


KANSAS

SECTION 20 TOWNSHIP 23 RANGE 14W

WELL NO. 1 Cornwell

COMPANY Barnett Drlg.

NORTH

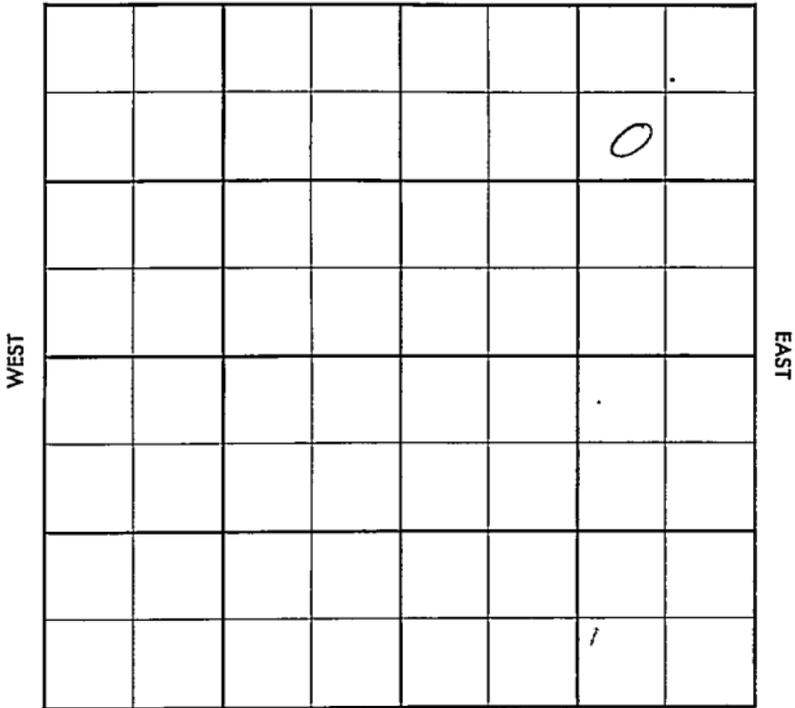

SOUTH

# WILDCAT

FORM 513 SUNRAY

County Stafford Elev. 1968  
Sec. 20 Twp. 23 Rge. 14W  
Company Barnett Drlg.  
Farm Name Cornwell No. 1

TOPS	DEPTH	LOG	DATUM
Anh.			
Tp.			
H.			
Tr.			
Dg.			
Bl.			
L.			
K.C.			
B.K.C.			
Ce.			
C.			
M.			
M.			
K.			
Mz.			
Ma.			
V.			
S.			
S.			
A.			
R.			
PE.			
G.			
T.D.			

Loc. in Sec. SW NE NE  
Geol. \_\_\_\_\_  
Contr. Barnett Tool  
Pool Wildcat  
REPORT  
DEC 12 '56

Date Comm. 12-6-56  
8" @ 226 w/175, drlg. 2785

13

Co.  
No.  
Sec.  
T.  
R.

County Stafford Elev. 1968  
 Sec. 20 Twp. 23 Rge. 14W  
 Company Barnett Drilling  
 Farm Name Cornwell No. I

TOPS	DEPTH	LOG	DATUM	Loc in Sec.
Anb.				SW NE NE
Tr.				
H.	3426			
Dg.				
Bl.	3559			
L.	3571			
K.C.				Geol.
B.K.C.	3830			Contr.
Ce.				Barnett Tool
C.	3878			Well
M.				Prod
M.				Wildcat
K.				
Mz.				
Mo.				
V. <i>cherty</i>	3950			
S.	4008			
S.				
A.	4047			
R.				
PE.				
G.				ABANDONED
TR.	4064			

Date Comm. 12-6-56  
8" @ 226 w/175, drlg. 2785 DEC 19 56  
DST 3689-3703 90" rec 150'  
SOCW + 36' OCM F.P. 0-70  
BHP 1030

*DEA*