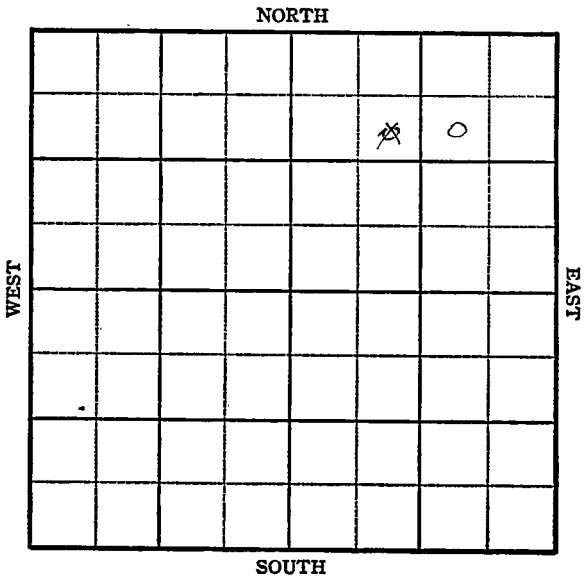


KANSAS

Pawnee

FORM 51 5M PETROL

Section 20 Township 23 Range 15WWell No. 1 HallCompany Skelly

KANSAS

Pawnee

Sec. 20 Twp. 23 R. 15-W

Well No. #1 Hall Farm


Skelly Company

990 Ft. from N. Line

 Ft. from S. Line

990 Ft. from E. Line

~~990~~ Ft. from W. Line

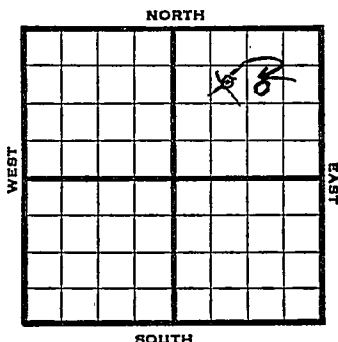

~~SE NW NE~~ SW NE NE

1945 Elev. 2039 REPORT

10/17 Location

10/24 RUR

10/31 8" @ 951

Dr lg. 1451

11/7 Dr lg. 3130'

11/14 Topeka 3140

Lans. 3662

Viola 4063

Dr lg. 4085'

11/21 Arb. 4157

TD 4171'

ABANDONED

KANSAS
Kansas Pool Name WilcatMap No. 83 Sec. 20 Twp. 23 R. 15WWell No. 1 HallSkelly


Company

FIRST REPORT

Contractor

SE NW NE

SECTION PLAT

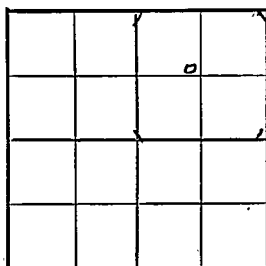990 Ft. from N. Line Ft. from S. Line Ft. from E. Line990 Ft. from W. Line

Pawnee County

Location XRig up

Drilling and Remarks:

RECORD

Cased in. ft.Sand Gas Oil Total Depth

PRODUCTION

1st 24 hrs. Nat. 1st 24 hrs. after shot Gas Cu. Ft.Dry Hole Abandoned

Date

OCT 17 1945

19

S. J. LEWIS

Scout

KANSAS Kansas Pool Name Wildcat
 Map No. 83 Sec. 20 Twp. 23 R. 15W
 Well No. 1 Hall


Skelly Company
CORRECTION Contractor

SW NE NE

SECTION PLAT

990 Ft. from N. Line Ft. from S. Line990 Ft. from E. Line Ft. from W. Line

Pawnee County

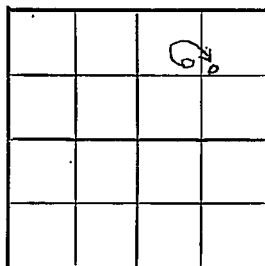Location Rig up
 Drilling and Remarks:
reported SE NW NE

RECORD

Cased in., ft.Sand Gas Oil Total Depth

PRODUCTION

1st 24 hrs. Nat. 1st 24 hrs. after shot Gas Cu. Ft.Dry Hole Abandoned

Date

OCT 24 1945 19 S. J. LEWIS Scout

Pool Name Wildcat

KANSAS

Kansas

Map No. 83 Sec. 20 Twp. 23 R. 15WWell No. 1 Hall

Skelly _____ Company

ABANDONED

Contractor

SW NE NE

E 12089
SECTION PLAT990 Ft. from N. Line Ft. from S. Line990 Ft. from E. Line Ft. from W. Line

			o

Pawnee County

Location _____

Rig up _____

Drilling and Remarks:

Per X 4107

RECORD

Cased _____ in., _____ ft.

Sand _____

Gas _____

Oil _____

Total Depth 4171

PRODUCTION

1st 24 hrs. Nat. _____

1st 24 hrs. after shot _____

Gas _____ Cu. Ft.

Dry Hole _____

Abandoned _____

Date

NOV 21 1945 19

S. J. LEWIS Scout