


Section 20 Township 23 Range 17W

Well No. #3 Shoemake

Company Hilton Drlg

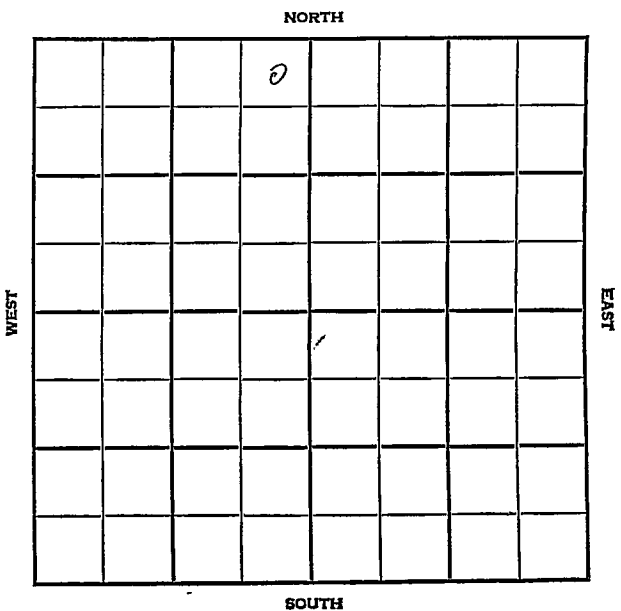

3



 Sec. 20 Twp. 23 Rge. 17W  
 Company Hilton Drlg.  
 FarmName Shoemake No. 3

TOPS	DEPTH	LOG	DATUM
Anb.			
Tp.			
H.			
Tr.			
Dg.			
Bl.			
L.			
K.C.			
B.K.C.			
Ce.			
C.			
M.			
M.			
K.			
Mz.			
Me.			
V.			
S.			
S.			
A.			
R.			
Pe.			
G.			
TR.			

Loc. in Sec. NE NE NW  
 Geol. \_\_\_\_\_  
 Contr. Co. tools  
 Pool Garfield  
 JUN 6 1956  
 FIRST REPORT  
 I No. \_\_\_\_\_  
 Sec. \_\_\_\_\_  
 T. \_\_\_\_\_  
 R. \_\_\_\_\_

Date Comm. RUR

*[Large handwritten scribbles and signatures]*

2011 1 1 1956  
 R. G.  
 20 5

Co.

Use

No.

Sec.

T.

R.

County Paynee Elev. 2105  
 Sec. 20 Twp. 23 Rge. 17W  
 Company Hilton Drl.  
 Farm Name Shoemake No. 3

TOPS	DEPTH	LOG	DATUM	Loc. in Sec.
Anh.	1125			NW 1/4
TP.				
H.	3692			
Tr.				
Dg.				
Bl.	3800			
L.	3807			
K.C.				Geol.
B.K.C.				Contr.
C.				Co. tools
C. <u>5 1/4</u>	4240			Garfield
M. <u>cg chert</u>	4254			
M.	4278			
K.				
Mz.	4329			
Mo.				
V.				
S.				
S.				
A.				
R.				
PE.				
G.				
TD.	4370			

COMPLETE

Date Comm. 6-4 AUG 8 '56

RUR JUN 13 '56 8 - 210-2005X  
 1) 3325 JUN 20 '56 DST 4251-69 1hr  
 rec 5' Md BHP 25 DST  
 4240-77 1hr. rec 1220' G ip  
 rec 220' 50' GCM BHP 240/  
 DST 4278-4310 1hr. rec 40' Md  
 All press. Rng 5 1/2 @ JUN 27 '56  
 @ 4368/150 co 4349 1/2 36/  
 4266-72 tst 2 goph + 2 gwph 1/4

20-23-17W NE NE NW

JUL 3 '56

JUL 11 '56

JUL 18 '56

\$ 2 1/2 Bopk

1940 wtu TER JUL 25 " Pop

AUG 1 '56

AUG 6 '56

Ph P. 28 Bopd

+ 26 40 wtu.

20-23-17W

NE NE NW