


Section 20 Township 23 Range 33W

Well No. #2 Garden City

Company ~~Ben Brack~~ Northern Pump

NORTH

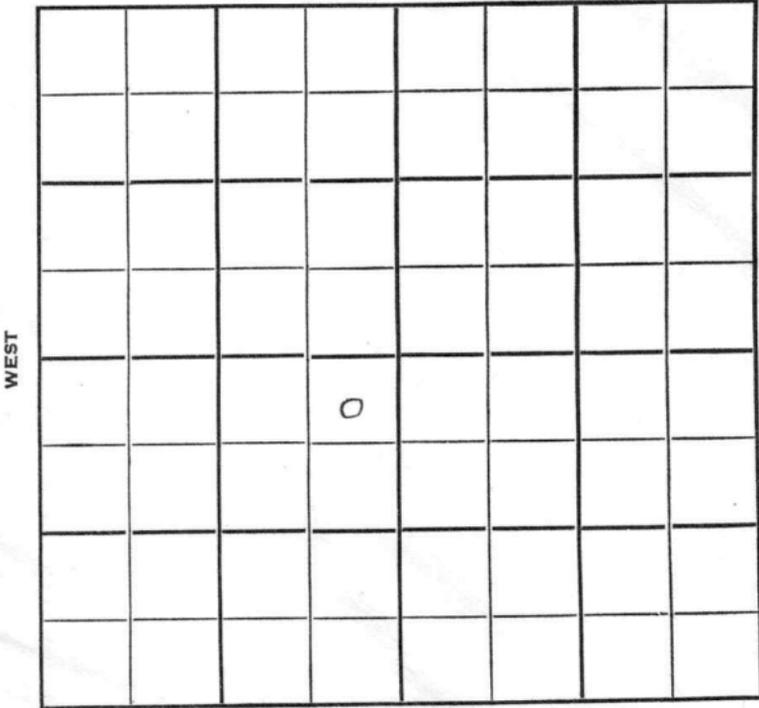

SOUTH

Finney

KANSAS
33W


Sec. 20 Twp. 23 R. 33W
 Well No. Northern Pump #2 Garden City Farm _____
Northern Pump Company _____
Ben Brack Contractor _____

330' Ft. from N. Line

_____ Ft. from S. Line

330' Ft. from E. Line

_____ Ft. from W. Line

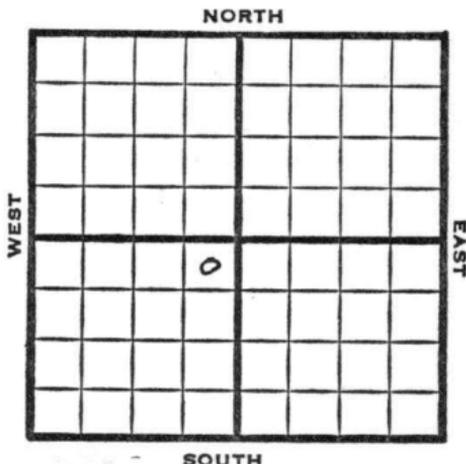

NE NE SW

1951

Elev. 2902' REPORT

9/12

Drlg.
Spud 8-6-51

1952

2/6

TD 2680 5" @ 2634

2/13

No report

2/20

"

3/5

NR

3/12

"

3/19

"

3/25

"

4/1

"

4/9

DO 2677 1000 A

4/23

NR

4/30

Gas Well TD 2680' 8" @ 388'
5" @ 2640' TD 2680

Hol 2508

Her. 2532

Kri. 2588

Win. 2579

DO to 2677 1000 A 54/ 2582-91

66/ 2598-2609 12/ 2627-29

1000 A 15, 750 total acid

Comp. 1,278,000 gas

COMPLETED


County **Finney** State **Kansas**

Sec. **20** (Blk. Twp.) **23** (Sur. Rge.) **33W** Map No.

Operator **Ben Braek** *Northern Pump*

Well No. **2** Farm **Garden City**

Elev. **2902** Location **NE NE SW**

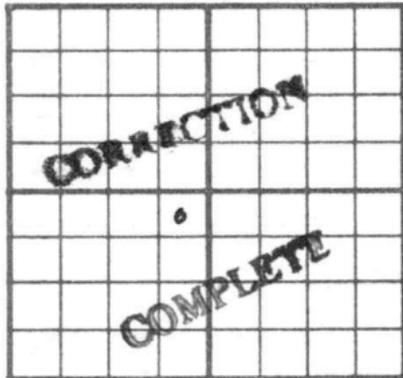

330 Ft. From **N** Line **SW**

330 Ft. From **E** Line **Quarter**

1st. Report

Completion **APR 30 1952**

Remarks

Spudding Date

Drlg. Data **Gas well** **TD 2680**

8" @ 388 **5" @ 2640** **TD 2680**

Hel. 2508 **Her. 2532** **Kri. 2548**

Win. 2579 **DO to 2677** **1000 A**

54/ 2582-91 **66/ 2598-2609**

12/ 2627-29 **1000 A** **15,750 total acid**

Comp. 1,278,000 gas