


Section 20 Township 23 Range 34W

Well No. #1 Hiney

Company Champlin Ref.

Hugoton Pool

NORTH

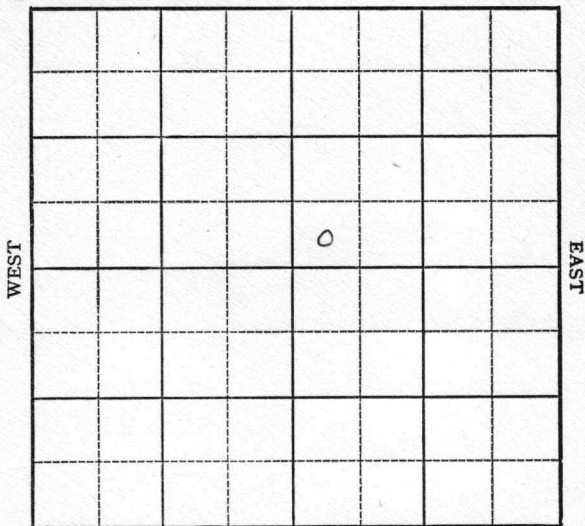

SOUTH

Finney KANSAS

Sec. 20 Twp. 23 R. 34W

Well No. #1 Hiney Farm

Champlin Ref.

Hugoton Pool (Champlin Ref., Contr.) Company


Ft. from N. Line

330' Ft. from S. Line

Ft. from E. Line

330' Ft. from W. Line

SW NE

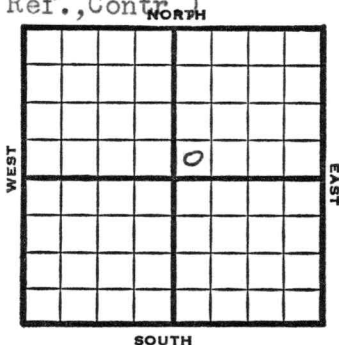

1949

Elev 2977'

REPORT

12/14

9" @ 633'
Drlg. 2300'

12/21

TD 2650'

12/28

"

1950

4/19

TD 2650'
9" @ 633'

Herington 2465'

Kriden 2494'

Winfield 2552'

Towanda 2606'

TD 2650'

18/2635-38

12/2630-32

48/2620-28

30/2601-12

3500 acid

30/2665-71

30/2553-58

90/2514-29

24/2504-08

31,500 acid

comp 9,150,000 gas

RP 420#

Comp

COMPLETED

Map No. _____ Sec. 20 Twp. 23 R. 34WWell No. 1 Hiney

Champlin Ref. _____ Company _____

Champlin Ref. _____ Contractor _____


SW NE

FIRST REPORT
SECTION PLAT

_____ Ft. from N. Line

330 Ft. from S. Line

_____ Ft. from E. Line

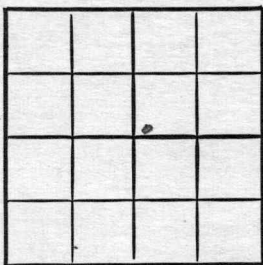330 Ft. from W. Line

Finney County

Location _____

Rig up _____

Drilling and Remarks:

9" @ 633

drlg. 2300

RECORD

Cased _____ in., _____ ft.

Sand _____

Gas _____

Oil _____

Total Depth _____

PRODUCTION

1st 24 hrs. Nat. _____

1st 24 hrs. after shot _____

Gas _____ Cu. Ft.

Dry Hole _____

Abandoned _____

Date

DEC 14 1949

19

S. J. LEWIS

Scout

Map No. _____ Sec. 20 Twp. 23 R. 34W

Well No. 1 Hiney

Champlin Ref.

Company

Contractor

SW NE

E. 2977
SECTION PLAT

_____ Ft. from N. Line

330

_____ Ft. from S. Line

_____ Ft. from E. Line

330

_____ Ft. from W. Line



Finney County

Location _____

Rig up _____

Drilling and Remarks:

9" C 633

Herington 2465

Krides 2494

Winfield 2552

Lawrence 2606

T.D. 2650

RECORD

Cased _____ in., _____ ft.

Sand _____

Gas _____

Oil _____

Total Depth 2650

PRODUCTION

1st 24 hrs. Nat. _____

1st 24 hrs. after shot _____

Gas _____ Cu. Ft.

Dry Hole _____

Abandoned _____

Date

APR 19 1950 19

J. E. TYRA Scout

18/ 2635-38

12/ 2630-32

48/ 2620-28

30/ 2601-12

3500 acid

30/ 2665-71

30/ 2553-58

90/ 2514-29

24/ 2504-08

31,500 acid

Comp. 9,150,000 gas
R.P. 420#



Scout Cards	
Land Small Map	
Land Wall Map	
Tracings	
France Map	
Pierce Map	
Misc.	

APR 28 1950