

Section 20 Township 23 Range 36WWell No. 1 G. MennCompany Stanolind Oil and Gas Company

NORTH

				6			

WEST

EAST

SOUTH

Kearny

KANSAS ✓

Sec. 20 Twp. 23 R. 36WWell No. #1 G. Menn FarmStanolind

Company

Contractor

Ft. from N. Line

150


Ft. from S. Line

Ft. from E. Line

150

Ft. from W. Line

SW NE

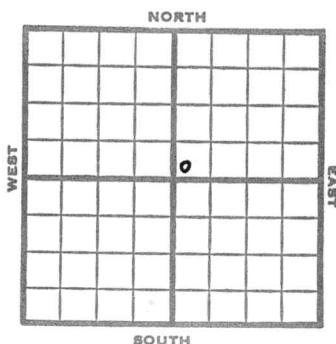

1953 Elev. 3219' REPORT

1/14 Location

1/22 "

1/29 8" @ 792
Drlg. 2090'2/5 RTD 2770
5" @ 2751Her 2596, Win 2646, Up Ft. 2710,
Low Ft. 27512/12 TD 2775, A-frac, 2000A
Plug 2744
24/2596-2600, 24/2606-10,
36/2616-22, 36/2626-32,
60/2640-50, 48/2653-61,
36/2666-72, 12/2680-92
24/2710-14, 90/2716-31,
14,000A

2/19 NR

2/26 N.R.

OVER

#1 G. Menn

1953
3/4

Spud 1-20-53

Gas Well

TD 2775

8" @ 792

Her 2596, Win 2646, Ft Riley
2710

TD 2775

5" @ 2751

2000 A SP 2744

24/2596-2600, 24/2606-10,

36/2616-22, 36/2626-32, 60/

2640-50, 48/2653-61, 36/2666-72,


12/2680-92, 24/2710-14, 90/

2716-31, 14000A

Comp. 5,647,000 gas, 300#

COMPLETED

County Kearny State Kansas
 Sec. 20 (Blk. 23) (Sur. 36W) Map No. 23
 Operator Stanolind
 Well No. 1 Farm G. Menn
 Elev. 3219 Location SW NE

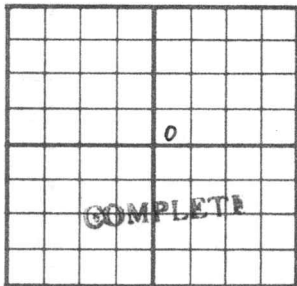

150 Ft. From S Line NE
150 Ft. From W Line Quarter

1st. Report

Completion MAR 4 1953

Remarks

Spudding Date 1-20-53

Drig. Data Gas well TD 2775

8" @ 792 Her. 2596 Win. 2646

Ft. Riley 2710 TD 2775 5" @ 2751

2000 A SP 2744 24/ 2596-2600

24/ 2606-10 36/ 2616-22 36/ 2626-32

60/ 2640-50 48/ 2653-61 36/ 2666-72

12/ 2680-92 24/ 2710-14 90/ 2716-31

14000 A Comp. 5,647,000 gas 300#

J. G. McGEHEE